

Perry Co
 A 30
 5-1-70

MISSISSIPPI
 BOARD OF WATER COMMISSIONERS
 416 North State Street
 Jackson, Mississippi 39201

WATER WELL DRILLERS LOG

5-1-1970 date well completed
 Cochran & Rayburn Perry firm name
 Drilling Service county well located

LANDOWNER:
 Leray Hinton
 Route 3 Richton
 (mailing address)

description of formations encountered	from to	
	feet	feet
Top soil	0	3
clay Red	3	11
Sand	11	15
Blue clay	13	46
Sand fine	46	54
Sand Good	54	68

WELL LOCATION:
 sec. 17 T. 5 S. R. 11 E.
 2 miles N of Tunnelton
 (distance) (direction) (nearest town)

WELL PURPOSE: none
 (home, irrigation, municipal, industrial)

- WELL COMPLETION DATA:
- (1) diameter (inches) 2
 - (2) total depth (feet) 68
 - (3) static water level (feet) 53 ^{below} top of ground.
 - (4) casing PVC, 63 (material) (depth)
 (size) if telescope see back.
 - (5) screen 5, 63 (length) (depth to top)
 2, PVC (size) (material)
 - (6) pump 1, 6 1/2 (HP) (yield gpm)
 Elec. (type power)
 - (7) electric log No (yes or no)
 (organization running log)
 - (8) how well bottom plugged Valve

MAY 7 1970


DRILLERS REMARKS:

MISS. BD. OF
 WATER COMM.

68

If well telescopes please sketch and show depths.

GROUND LEVEL

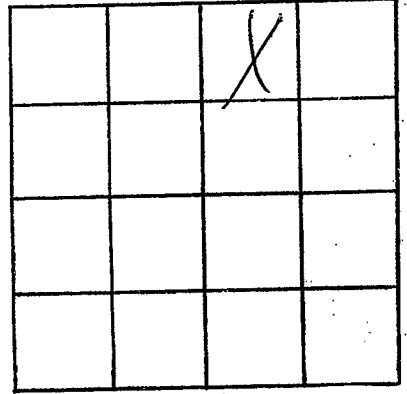

SECTION 17

Please indicate well location X.

ADDITIONAL INFORMATION

If more than one screen,
show locations of each on sketch.