

Perry Co

A 31

4-3-70

MISSISSIPPI BOARD OF WATER COMMISSIONERS  
416 North State Street  
Jackson, Mississippi 39201

WATER WELL DRILLERS LOG

4-3-1970 Cochran Raybon Perry  
date well completed firm name county well located  
Drilling Service

LANDOWNER:

Base Ball Odum

Route Richton  
(mailing address)

description of formations encountered

from to

top soil	0	3
sandy soil	3	5
clay & red	5	12
sand	12	18
clay gray	18	22
sand	22	45

WELL LOCATION:

sec. 28 T 5 S R 11 E  
miles in of Pannelston  
(distance) (direction) (nearest town)

WELL PURPOSE: home  
(home, irrigation, municipal, industrial)

WELL COMPLETION DATA:

- (1) diameter (inches) 2
- (2) total depth (feet) 45
- (3) static water level (feet) 22 below top of ground.
- (4) casing PVC 40 (material) (depth)
- (size) If telescope see back.
- (5) screen 5 40 (length) (depth to top)
- 2 PVC (size) (material)
- (6) pump 3/4 5 1/2 (HP) (yield gpm)
- Etc. (type power)
- (7) electric log No (yes or no)

(organization running log)

(8) how well bottom plugged Valve


WAY 7 1970

DRILLERS REMARKS:

MISS. Bd. OF WATER COMMISSIONERS

If well telescopes please sketch and show depths.

GROUND LEVEL

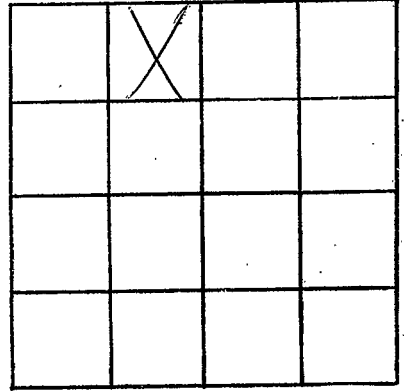

SECTION 28

Please indicate well location X.

ADDITIONAL INFORMATION

If more than one screen,  
show locations of each on sketch.