

Perry Co  
 A 32  
 9-15-69

MISSISSIPPI  
 BOARD OF WATER COMMISSIONERS  
 416 North State Street  
 Jackson, Mississippi 39201

WATER WELL DRILLERS LOG

*Time Drilling Service Perry*

Date well completed

19

firm name

county well located

*September 15-1969*

LANDOWNER:

*Panneltown*

description of formations encountered

from

to

*High Farm Pt. 2*  
 (mailing address)

<i>Clay</i>	<i>0</i>	<i>15</i>
<i>sand and gravel</i>	<i>15</i>	<i>30</i>
<i>blue clay</i>	<i>30</i>	<i>60</i>
<i>sand</i>	<i>60</i>	<i>80</i>
<i>Clay &amp; shale</i>	<i>80</i>	<i>250</i>
<i>sand</i>	<i>250</i>	<i>295</i>

WELL LOCATION:

sec *33* T *5* N R *11* E *116*  
*1 1/2* miles *South* of *Panneltown*  
 (distance) (direction) (nearest town)

WELL PURPOSE: *industrial*  
 (home, irrigation, municipal, industrial)

WELL COMPLETION DATA:


- (1) diameter (inches) *4 inch*
- (2) total depth (feet) *295*
- (3) static water level (feet) *5* below top of ground.
- (4) casing *Plastic* *270* ft. (material) (depth)
- (size) if telescope see back.
- (5) screen *25* ft. (length) (depth to top)  
*4 inch Plastic* (size) (material)
- (6) pump *5* *100* (HP) (yield gpm)  
*Electric* (type power)
- (7) electric log *No* (yes or no)  
*none* (organization running log)

(8) how well bottom plugged *backwash valve*

DRILLERS REMARKS:

If well telescopes please sketch and show depths.

GROUND LEVEL

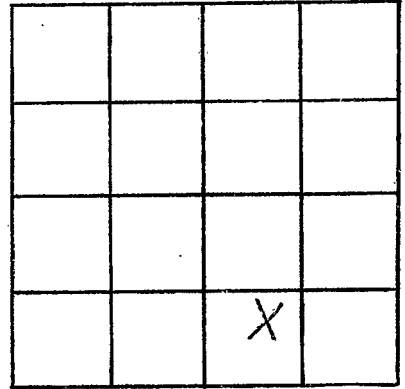

SECTION 33

Please indicate well location X.

ADDITIONAL INFORMATION

If more than one screen,  
show locations of each on sketch.