

CODED

MISSISSIPPI
BOARD OF WATER COMMISSIONERS
416 North State Street
Jackson, Mississippi 39201

WATER WELL DRILLERS LOG

Sta 6/22/70
Reid bank 6/29/70

Perry Co
A 34
5-12-70

5-12 1970 date well completed
Cochran & Rayburn Perry firm name
county well located

LANDOWNER:

Goody Hinton
Rt. 1, Overt, MS
(mailing address)

description of formations encountered

from to

Top Soil	0	3 1/2
Red Clay	3 1/2	12
Red Sand	12	26
Blue Clay	26	36
Good water sand	36	52

WELL LOCATION:

sec. 17 T 50 N R 14 E
2 miles N of Runnel town
(distance) (direction) (nearest town)

WELL PURPOSE: home
(home, irrigation, municipal, industrial)

WELL COMPLETION DATA:

- (1) diameter (inches) 2
- (2) total depth (feet) 52
- (3) static water level (feet) 35 (below above top of ground)
- (4) casing Plastic 47 (material) (depth)
(size) If telescope see back.
- (5) screen 5 47 (length) (depth to top)
2 Plastic (size) (material)
- (6) pump 1 7 (HP) (yield gpm)
Elec. (type power)
- (7) electric log No. (yes or no)
- (organization running log)
- (8) how well bottom plugged Valve

CODED

6/29/70

DRILLERS REMARKS:


Parnell Cochran

JUN 22 1970

MISSISSIPPI
WATER COMMISSIONERS

If well telescopes please sketch and show depths.

GROUND LEVEL

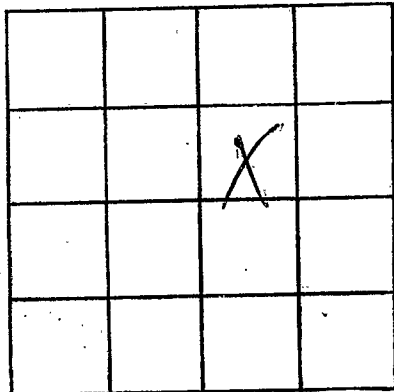

SECTION 17

Please indicate well location X.

ADDITIONAL INFORMATION

If more than one screen, show locations of each on sketch.