

MISSISSIPPI  
BOARD OF WATER COMMISSIONERS  
416 North State Street  
Jackson, Mississippi 39201

**CODED**

WATER WELL DRILLERS LOG

Perry  
A35  
5-30-70

5-30  
date well completed

1970 Cochran & Rayborn  
firm name

Perry  
county well located

LANDOWNER:

Forrest Hensarling  
Rt 2, H'burg, MS  
(mailing address)

description of formations encountered

from to

<u>Sandy Soil</u>	<u>0</u>	<u>4</u>
<u>Clay</u>	<u>4</u>	<u>12</u>
<u>Blue Clay</u>	<u>12</u>	<u>20</u>
<u>Sand &amp; Gravel</u>	<u>20</u>	<u>45</u>

WELL LOCATION:

sec. 32 5 N R. 11 E  
3 miles SW of Bunnell town  
(distance), (direction) (nearest town)

WELL PURPOSE: home  
(home, irrigation, municipal, industrial)

WELL COMPLETION DATA:

- (1) diameter (inches) 2
- (2) total depth (feet) 45
- (3) static water level (feet) 8 below above top of ground.
- (4) casing Plastic 40  
(material) (depth)  
(size) If telescope see back.
- (5) screen 5 40  
(length) (depth to top)  
2 Plastic  
(size) (material)
- (6) pump 1/2 6  
(HP) (yield gpm)  
Elec.  
(type power)
- (7) electric log No.  
(yes or no)
- (organization running log)
- (8) how well bottom plugged Value

**CODED**

MAY 22 1970


DRILLERS REMARKS:

[Signature]

MISS. BD. OF  
WATER COMMISSIONERS

If well telescopes please sketch and show depths.

GROUND LEVEL

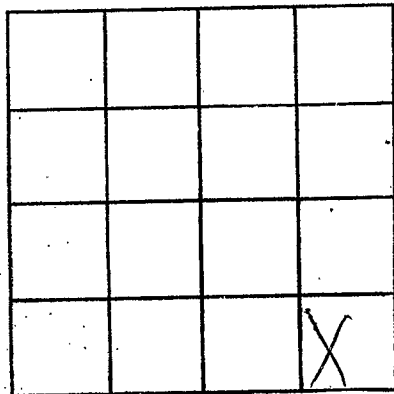

SECTION 32

Please indicate well location X.

ADDITIONAL INFORMATION

If more than one screen,  
show locations of each on sketch.