

2 Wells
②

PERRY
A 36
6-2-70

MISSISSIPPI
BOARD OF WATER COMMISSIONERS
416 North State Street
Jackson, Mississippi 39201

CODED

WATER WELL DRILLERS LOG

6-2 1970 Cochran Drilling Perry
date well completed firm name county well located

LANDOWNER:
R. C. Hensarling
Rt 2, A'burg
(mailing address)

description of formations encountered	from	to
Top Soil	0	4
Red Clay	4	6
Sand	6	24

WELL LOCATION:
sec. 29 T 5 N R 11 E
1 miles SW of Kanneltown
(distance) (direction) (nearest town)

WELL PURPOSE: Noa parter
(home, irrigation, municipal, industrial)

- WELL COMPLETION DATA:
- (1) diameter (inches) 2
 - (2) total depth (feet) 24
 - (3) static water level (feet) 5 ^{below} top of ground
 - (4) casing plastic, 19 (material) (depth)
(size) if telescope see back.
 - (5) screen 5 19 (length) (depth to top)
2 PVC (size) (material)
 - (6) pump 1 7 (HP) (yield gpm)
Elect (type power)
 - (7) electric log no. (yes or no)
 - (organization running log)
 - (8) how well bottom plugged Value


CODED

DRILLERS REMARKS:

AUG 13 1970

If well telescopes please sketch and show depths.

GROUND LEVEL

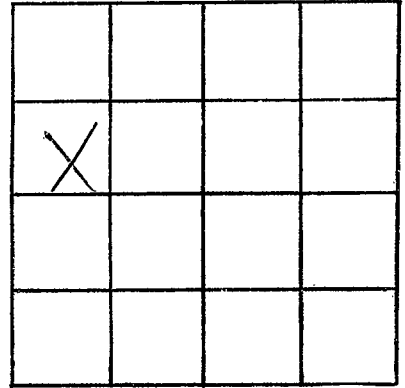

SECTION 29

Please indicate well location X.

ADDITIONAL INFORMATION

If more than one screen,
show locations of each on sketch.