

2 Wells ①

MISSISSIPPI
BOARD OF WATER COMMISSIONERS
416 North State Street
Jackson, Mississippi 39201

CODED

WATER WELL DRILLERS LOG

PERRY
A 37
6-3-70

6-3 1970 Cochran Drilling Perry county well located
date well completed firm name

LANDOWNER:

R.C. Hensarling
Route 2 Hattisburg
(mailing address)

description of formations encountered

from to

top soil 0 6
Red Clay 6 8
Sand 8 28

WELL LOCATION:

sec 29 T 5 N R 11 E
S
1 miles SW of Rumboldt
(distance) (direction) (nearest town)

WELL PURPOSE: Drain Parlor
(home, irrigation, municipal, industrial)

WELL COMPLETION DATA:

- (1) diameter (inches) 2
- (2) total depth (feet) 28
- (3) static water level (feet) 4 ^{below} _{above} top of ground.
- (4) casing Plastic 23
(material) (depth)
- (size) if telescope see back.
- (5) screen 5 23
(length) (depth to top)
- (size) 2 PVC
(material)
- (6) pump 1 8
(HP) (yield gpm)
- (type power) Elec
- (7) electric log No
(yes or no)
- (organization running log)
- (8) how well bottom plugged Value

CODED


AUG 13 1970

MISS. BD. OF
WATER COMM.

DRILLERS REMARKS:

If well telescopes please sketch and show depths.

GROUND LEVEL

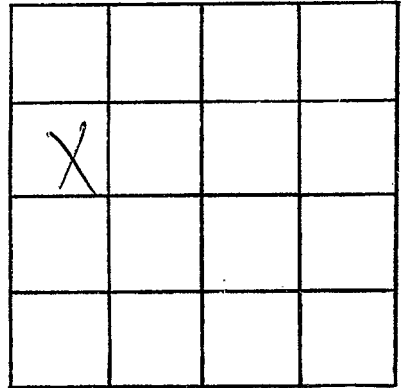

SECTION 29

Please indicate well location X.

ADDITIONAL INFORMATION

If more than one screen,
show locations of each on sketch.