

PERRY
A38
6-18-70

MISSISSIPPI
BOARD OF WATER COMMISSIONERS
416 North State Street
Jackson, Mississippi 39201

CODED

WATER WELL DRILLERS LOG

6-18 1970 Cochran Drilling Perry
date well completed firm name county well located

LANDOWNER:

Mrs. Harvey
Rt 2, Hattiesburg
(mailing address)

description of formations encountered

from to

Top soil	0	3
Red Clay	3	12
Red sand	12	18
Sand	18	35
Gravel	35	42
Clay - Gray	42	58
Sand - Red	58	74
Sand	74	105

WELL LOCATION:

sec. 30 T. 5 N R. 11 E
1 1/2 miles W of Runnels
(distance) (direction) (nearest town)

WELL PURPOSE: home
(home, irrigation, municipal, industrial)

WELL COMPLETION DATA:

- (1) diameter (inches) 2
- (2) total depth (feet) 105
- (3) static water level (feet) 47 ^{below} above top of ground.
- (4) casing plastic 100
(material) (depth)
- (size) if telescope see back.
- (5) screen 5 100
(length) (depth to top)
- (size) 2 p.v.c.
(size) (material)
- (6) pump 1 7
(HP) (yield gpm)
- Elect
(type power)
- (7) electric log No.
(yes or no)

CODED


(organization running log)
(8) how well bottom plugged Value

DRILLERS REMARKS:

AUG 13 1970

If well telescopes please sketch and show depths.

GROUND LEVEL

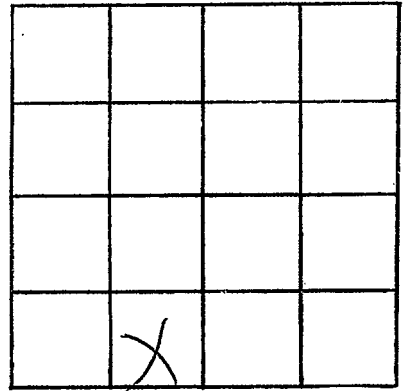

SECTION 30

Please indicate well location X.

ADDITIONAL INFORMATION

If more than one screen,
show locations of each on sketch.