

PERRY
A 39
6-21-70

MISSISSIPPI
BOARD OF WATER COMMISSIONERS
416 North State Street
Jackson, Mississippi 39201

CODED

WATER WELL DRILLERS LOG

6-21 1970 Cochran Drilling Perry
date well completed firm name county well located

LANDOWNER:
Mr. Buck Narvey
Rt. 2, Hattiesburg
(mailing address)

description of formations encountered	from	to
Top Soil	0	3
Red Clay	3	10
Sand + Clay	10	18
Sand	18	24
Blue Clay	24	42
Sand	42	65

WELL LOCATION:
sec. 30 T 5 N R 11 E
S W
1 1/2 miles W of Rinneletown
(distance) (direction) (nearest town)

WELL PURPOSE: home
(home, irrigation, municipal, industrial)

WELL COMPLETION DATA:

(1) diameter (inches) 2

(2) total depth (feet) 65

(3) static water level (feet) 46 below top of ground.

(4) casing Plastic 60 (material) (depth)

(size) If telescope see back.

(5) screen 5 60 (length) (depth to top)

2 PVC (size) (material)

(6) pump 1 6 (HP) (yield gpm)

Elec. (type power)

(7) electric log No (yes or no)

(organization running log)

(8) how well bottom plugged Value


CODED

DRILLERS REMARKS:

AUG 13 1970

If well telescopes please sketch and show depths.

GROUND LEVEL

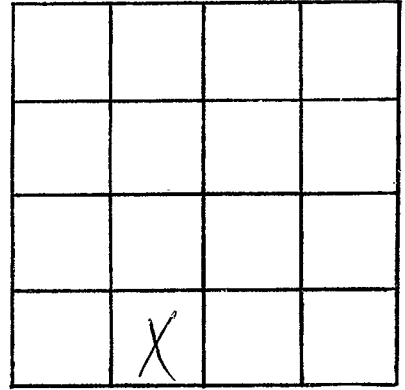

SECTION 30

Please indicate well location X.

ADDITIONAL INFORMATION

If more than one screen,
show locations of each on sketch.