

MISSISSIPPI
BOARD OF WATER COMMISSIONERS
416 North State Street
Jackson, Mississippi 39201

CODED

WATER WELL DRILLERS LOG

PERRY
A 40
7-10-70

7-10-1970 Cochran Drilling Perry
date well completed firm name county well located

LANDOWNER:

description of formations encountered

from

to

Cassie Coats
Route 2 Hattiesburg
(mailing address)

Soil
Sandy soil
Clay
Sand 2

0	4
4	7
7	14
14	26

WELL LOCATION:

sec. 29 T 5 N R 11 E
S W
1 miles W of Remondale
(distance) (direction) (nearest town)

WELL PURPOSE: dry well
(home, irrigation, municipal, industrial)

WELL COMPLETION DATA:

- (1) diameter (inches) 2
- (2) total depth (feet) 26
- (3) static water level (feet) 4 ^{below} top of ground
- (4) casing Plastic 21
(material) (depth)
- (size) if telescope see back.
- (5) screen 5 21
(length) (depth to top)
- (size) 2 PVC
(material)
- (6) pump 1 8 1/2
(HP) (yield gpm)
- (type power) Elec
- (7) electric log NO
(yes or no)
- (organization running log)
- (8) how well bottom plugged Valve

CODED


AUG 13 1970

DRILLERS REMARKS:

Miss. Bd. of
Water Comm.

If well telescopes please sketch and show depths.

GROUND LEVEL

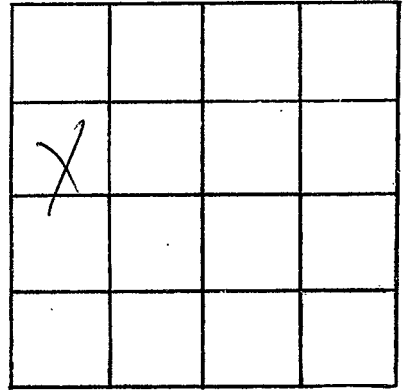

SECTION 29

Please indicate well location X.

ADDITIONAL INFORMATION

If more than one screen,
show locations of each on sketch.