

PERRY
A4
11-28-70

MISSISSIPPI
BOARD OF WATER COMMISSIONERS
416 North State Street
Jackson, Mississippi 39201

CODED

WATER WELL DRILLERS LOG

Nov. 28 1970 Cochran Drillers Perry
date well completed firm name county well located

LANDOWNER:

Mr. Roger Blackard
Route 3 Richtown
(mailing address)

description of formations
encountered

from to

Sand Soil	0	6
Clay Red	6	18
Sand	18	24
Clay White	24	65
Clay Blue	65	143
Sand	143	170

WELL LOCATION:

sec. 23 T. 5 N R. 11 E
S
2 miles E of Punnett
(distance) (direction) (nearest town)

WELL PURPOSE: house
(home, irrigation, municipal, industrial)

WELL COMPLETION DATA:

- (1) diameter (inches) 2
- (2) total depth (feet) 170
- (3) static water level (feet) 120 ^{below} above
top of ground.
- (4) casing pvc 160
(material) (depth)
- (size) If telescope see back.
- (5) screen 10 160
(length) (depth to top)
- 2 pvc
(size) (material)
- (6) pump 1 1/2 6
(HP) (yield gpm)
- elec
(type power)
- (7) electric log No
(yes or no)

CODED

(organization running log)

(8) how well bottom plugged Yes


DRILLERS REMARKS:

JAN 22 1971

MISS. BD. OF
WATER COM.

If well telescopes please
sketch and show depths.

GROUND LEVEL

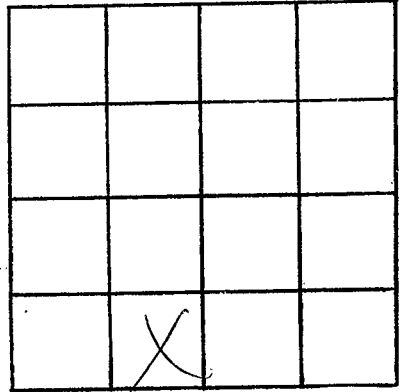

SECTION 23

Please indicate well location X.

ADDITIONAL INFORMATION

If more than one screen,
show locations of each on sketch.