

PERRY  
 H42  
 3-24-71

MISSISSIPPI  
 BOARD OF WATER COMMISSIONERS  
 416 North State Street  
 Jackson, Mississippi 39201

**CODED**

WATER WELL DRILLERS LOG

3-24 1971 Howey Rayborn wells Perry  
 date well completed firm name county well located

LANDOWNER: NC Hallinan

description of formations encountered	from	to
---------------------------------------	------	----

Route 1 Quatt Miss.  
 (mailing address)

<u>Clay</u>	<u>0</u>	<u>10</u>
<u>Sand and gravel</u>	<u>10</u>	<u>12</u>
<u>Sand</u>	<u>12</u>	<u>50</u>

WELL LOCATION:  
 sec. 1 T. 5 (N) S R. 11 E  
5 miles NE of Rumeltown  
 (distance) (direction) (nearest town)

WELL PURPOSE:  
 (home) irrigation, municipal, industrial

WELL COMPLETION DATA:

- (1) diameter (inches) 4"
- (2) total depth (feet) 50'
- (3) static water level (feet) 12' below top of ground.
- (4) casing PVC, 40'  
 (material) (depth)  
 (size) if telescope see back.
- (5) screen 10', 40'  
 (length) (depth to top)  
4", PVC  
 (size) (material)
- (6) pump 3/4, 9  
 (HP) (yield gpm)  
110  
 (type power)
- (7) electric log No  
 (yes or no)

**CODED**

(organization running log)

(8) how well bottom plugged BPV


APR 29 1971

MISS. BD. OF  
 WATER COMM.

DRILLERS REMARKS:

If well telescopes please  
sketch and show depths.

GROUND LEVEL

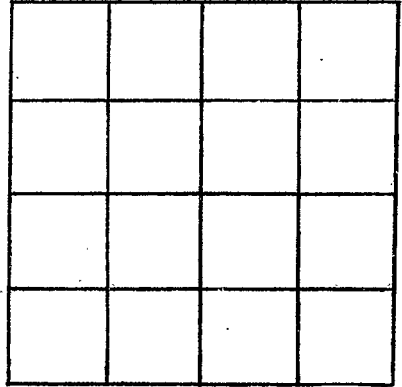

SECTION \_\_\_\_\_

Please indicate well location X.

ADDITIONAL INFORMATION

If more than one screen,  
show locations of each on sketch.