

PERRY
A43
8-2-64

MISSISSIPPI BOARD OF WATER COMMISSIONERS

WATER WELL DRILLERS LOG **CODED**

Date: 8-2, 1964, Driller: Gr. L. Moore County Barry
971/37 (Name)

(1) Owner of Land: Less Brady
(Name)
Hatterburg Miss RT 2
(Address)

(2) Location: 1/4, 1/4, Sec. 31 T5 R11
_____ miles _____ of _____
(distance) (direction) (Nearest Town)

(3) Topography: _____
(Hilly) (Flat) (Level)

(4) Purpose of Well: _____
(Domestic Irrigation
Municipal, Industrial, Other)

Description & Color of Materials Sand, Clay, Red Clay, Shell, etc.	Thick- ness Feet	Depth Feet
<u>Surf</u>	<u>0</u>	<u>20</u>
<u>Snd & shon</u>	<u>20</u>	<u>40</u>
<u>Clay Red sh</u>	<u>90</u>	<u>66</u>
<u>Red sh</u>		
<u>With Snd</u>	<u>90</u>	<u>123</u>
<u>& shon RT 2</u>		<u>33</u>

9th **PLASTIC**
Information upon completion of well:

(1) Diameter 2 1/2 inches.

(2) Total Depth 123 feet.

(3) Water Level 90 feet below top of ground.


(4) Cased to 118, Size 2

(5) Screen: Size 2", Length 5'

(6) Were any formations sealed against pollution?
_____ yes, _____ no.

If YES depth of formation _____
Why _____

Drillers Remarks:
Why 1" Plastic
111 of sub

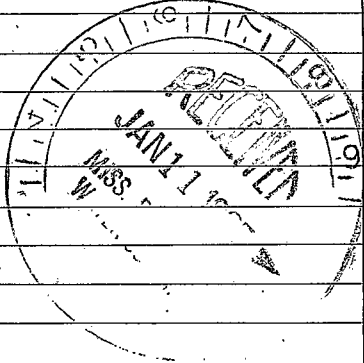

(Use Back Side)

86

Well No.

