

PERRY

A44

5-5-71

MISSISSIPPI
 BOARD OF WATER COMMISSIONERS
 416 North State Street
 Jackson, Mississippi 39201

CODED

WATER WELL DRILLERS LOG

May 5 1971 Richard Drillers Perry
 date well completed firm name county well located

LANDOWNER:

S.A. Sensenling

Road 8 Hlong
(mailing address)

description of formations encountered

from

to

Top Soil	0	3 1/2
Red Clay	3 1/2	10
Blue Clay	10	21
Sand	21	35

WELL LOCATION:

sec. 31 T. 5 (N) R. 11 E (W)
2 1/2 miles (distance) SW (direction) of Punnett (nearest town)

WELL PURPOSE:

Home (home, irrigation, municipal, industrial)

WELL COMPLETION DATA:

- (1) diameter (inches) 2
- (2) total depth (feet) 35
- (3) static water level (feet) 20 below top of ground.
- (4) casing Plc (material), 30 (depth)
 (size) if telescope see back.
- (5) screen 5 (length), 30 (depth to top)
2 (size), Plc (material)
- (6) pump 1 (HP), 5 1/2 (yield gpm)
Electric (type power)
- (7) electric log No (yes or no)
 (organization running log)
- (8) how well bottom plugged None

CODED


JUN 28 1971

DRILLERS REMARKS:

MISS. BD. OF WATER COMMISSIONERS

If well telescopes please sketch and show depths.

GROUND LEVEL

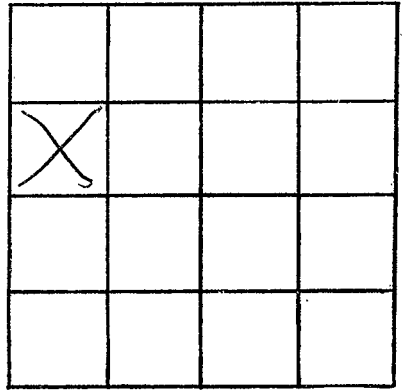

SECTION 31

Please indicate well location X.

ADDITIONAL INFORMATION

If more than one screen,
show locations of each on sketch.