

MISSISSIPPI
BOARD OF WATER COMMISSIONERS
416 North State Street
Jackson, Mississippi 39201

CODED

WATER WELL DRILLERS LOG

PERRY
A 45
5-14-71

May 14 1971 Rockwell Drilling Co Perry
date well completed firm name county well located

LANDOWNER:
W.D. Soules
Route 3 Richtown
(mailing address)

WELL LOCATION:
sec. 21 T 5 N R 11 E
3 1/2 miles N of Umatah
(distance) (direction) (nearest town)

WELL PURPOSE: Home
(home, irrigation, municipal, industrial)

WELL COMPLETION DATA:

(1) diameter (inches) 2

(2) total depth (feet) 345

(3) static water level (feet) 72 ^{below}/_{above} top of ground.

(4) casing PVC 335
(material) (depth)
(size) If telescope see back.

(5) screen 10 335
(length) (depth to top)
2 PVC
(size) (material)

(6) pump 6 1/2
(HP) (yield gpm)
Elect
(type power)

(7) electric log No
(yes or no)
(organization running log)

(8) how well bottom plugged Very

| description of formations encountered | from | to |
|---------------------------------------|--------------|--------------|
| <u>Top Soil</u> | <u>0</u> | <u>2 1/2</u> |
| <u>Red Clay</u> | <u>2 1/2</u> | <u>16</u> |
| <u>Fine Sand</u> | <u>16</u> | <u>28</u> |
| <u>White Clay</u> | <u>28</u> | <u>91</u> |
| <u>Blue Clay</u> | <u>91</u> | <u>216</u> |
| <u>Fine Sand</u> | <u>216</u> | <u>222</u> |
| <u>Blue Clay</u> | <u>222</u> | <u>312</u> |
| <u>Shale</u> | <u>312</u> | <u>320</u> |
| <u>Sand</u> | <u>320</u> | <u>345</u> |

CODED


JUN 28 1971

DRILLERS REMARKS:

MISC. PD. OF
WATER COMM.

If well telescopes please sketch and show depths.

GROUND LEVEL

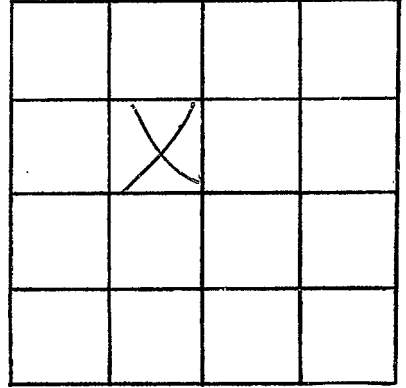

SECTION 26

Please indicate well location X.

ADDITIONAL INFORMATION

If more than one screen,
show locations of each on sketch.