

PERRY  
A 47  
10-2-71

MISSISSIPPI  
BOARD OF WATER COMMISSIONERS  
416 North State Street  
Jackson, Mississippi 39201

WATER WELL DRILLERS LOG

**CODED**

OCT 2 1971  
date well completed

Robertson's  
firm name

county well located

LANDOWNER: <u>R.H. Wolf</u> <u>Pt 8 Box 218</u> <u>Natliesburg, Miss</u> (mailing address)	description of formations encountered	from	to
	<u>Sandy Clay</u>	<u>0</u>	<u>6</u>
	<u>SAND &amp; GRAV</u>	<u>6</u>	<u>27</u>
WELL LOCATION:			
sec <u>19 T 5 N R 11 E</u> <u>S W</u>			
<u>1</u> miles <u>W</u> of <u>Prattville</u> (distance) (direction) (nearest town)			
WELL PURPOSE: (home, irrigation, municipal, industrial)			
WELL COMPLETION DATA:			
(1) diameter (inches) <u>4</u>			
(2) total depth (feet) <u>27</u>			
(3) static water level (feet) <u>11</u> below above top of ground.			
(4) casing <u>plastic 20</u> (material) (depth)			
<u>4</u> (size) if telescope see back.			
(5) screen <u>7</u> (length) <u>20</u> (depth to top)			
<u>4</u> (size) <u>plastic</u> (material)			
(6) pump <u>1/2</u> (HP) <u>150</u> (yield gpm)			
<u>JET</u> (type power)			
(7) electric log _____ (yes or no)			
_____ (organization running log)			
(8) how well bottom plugged <u>VALVE</u>			
DRILLERS REMARKS: <u>#13</u>			


**CODED**

OCT 12 1971

MISS. BD. OF  
WATER COMM.

If well telescopes please sketch and show depths.

GROUND LEVEL

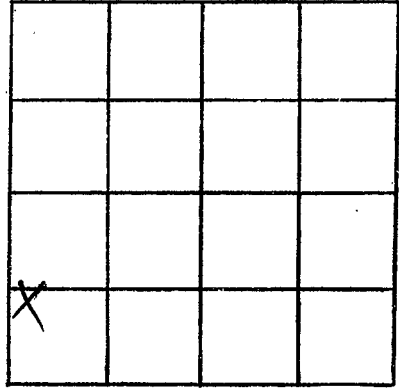

SECTION 19

Please indicate well location X.

ADDITIONAL INFORMATION

Lined area for additional information.

If more than one screen, show locations of each on sketch.