

Perry
A 50
1-3-72

MISSISSIPPI
BOARD OF WATER COMMISSIONERS FEB - 7 1972
416 North State Street
Jackson, Mississippi 39201

WATER WELL DRILLERS LOG CODED OF


1-3-72 19 date well completed
Robetis firm name
Perry county well located

LANDOWNER: <u>Mr. Sturge</u>	description of formations encountered	from	to
	<u>Clay</u>	<u>0</u>	<u>58</u>
	<u>Coarse Clay</u>	<u>58</u>	<u>72</u>
(mailing address)	<u>CW & Sub</u>	<u>72</u>	<u>127</u>
WELL LOCATION:			
sec. <u>8</u> T. <u>S</u> N ✓ R. <u>11</u> E			
<u>5</u> miles <u>N</u> of <u>Panola</u>			
(distance) (direction) (nearest town)			
WELL PURPOSE:			
(home) irrigation, municipal, industrial			
WELL COMPLETION DATA:			
(1) diameter (inches) <u>4"</u>			
(2) total depth (feet) <u>127</u>			
(3) static water level (feet) <u>60</u> below top of ground.			
(4) casing <u>plastic</u> , <u>117</u> (material) (depth)			
<u>4"</u> (size) if telescope see back.			
(5) screen <u>10</u> , <u>117</u> (length) (depth to top)			
<u>4"</u> , <u>plastic</u> (size) (material)			
(6) pump <u>3/4</u> , <u>900</u> (HP) (yield gpm)			
<u>Sub</u> (type power)			
(7) electric log _____ (yes or no)			
_____ (organization running log)			
(8) how well bottom plugged <u>None</u>			
DRILLERS REMARKS:			

CODED

If well telescopes please sketch and show depths.

GROUND LEVEL

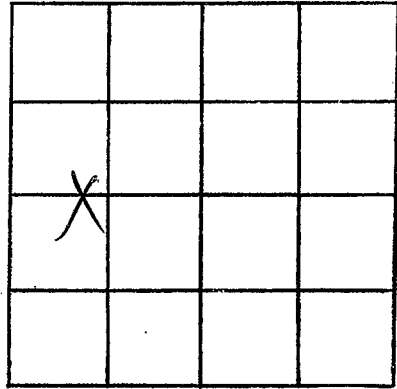

SECTION 8

Please indicate well location X.

ADDITIONAL INFORMATION

Lined area for providing additional information.

If more than one screen, show locations of each on sketch.