

PERRY
A 55
2-28-72

MISSISSIPPI
BOARD OF WATER COMMISSIONERS
416 North State Street
Jackson, Mississippi 39201

CODED

WATER WELL DRILLERS LOG

2-28-72 date well completed Robert's firm name Perry county well located

LANDOWNER: C.R. Andy

description of formations encountered

from to

Blue Clay
Sand Fills
CWB Sand

0 5
5 9
9-15

(mailing address)

WELL LOCATION:

sec. 19 T 5 N R 11 E
1 miles W of Remond
(distance) (direction) (nearest town)

WELL PURPOSE:

(home, irrigation, municipal, industrial)

WELL COMPLETION DATA:

- (1) diameter (inches) 2"
- (2) total depth (feet) 15
- (3) static water level (feet) 6 below above top of ground.
- (4) casing PVC, 10' (material) (depth)
2" (size) if telescope see back.
- (5) screen 5' 10' (length) (depth to top)
2" (size) PVC (material)
- (6) pump 1/2 (HP) 6000 (yield gpm)
Jet (type power)
- (7) electric log (yes or no)
- (organization running log)
- (8) how well bottom plugged Valve

CODED


SFP 28 1972

MISS. BD. OF
WATER COMMISSIONERS

DRILLERS REMARKS:

If well telescopes please sketch and show depths.

GROUND LEVEL

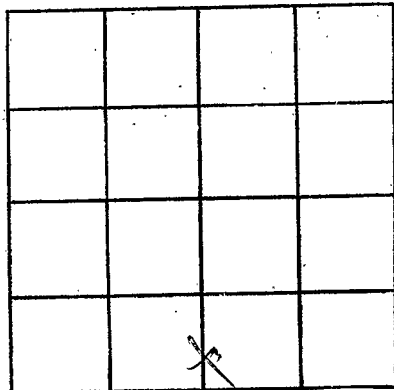

SECTION 19

Please indicate well location X.

ADDITIONAL INFORMATION

If more than one screen, show locations of each on sketch.