

Perry
A56

9-9-72

MISSISSIPPI
BOARD OF WATER COMMISSIONERS
416 North State Street
Jackson, Mississippi 39201

CODED

WATER WELL DRILLERS LOG

September 9, 1972 Cochran Drilling Service Perry
date well completed firm name county well located

LANDOWNER:

E. T. Davis

Rt. 2 Runnels town
(mailing address)

WELL LOCATION:

sec. 30 T-5 N R-11 E
S W
6 miles E of Petal
(distance) (direction) (nearest town)

WELL PURPOSE: home
(home, irrigation, municipal, industrial)

WELL COMPLETION DATA:

- (1) diameter (inches) 2"
- (2) total depth (feet) 45
- (3) static water level (feet) 2 below top of ground.
- (4) casing PVC, 40' (material) (depth)
(size) If telescope see back.
- (5) screen 5' 40' (length) (depth to top)
2" PVC (size) (material)
- (6) pump 1 10 (HP) (yield gpm)
Electric (type power)
- (7) electric log no (yes or no)

(organization running log)
(8) how well bottom plugged valve

DRILLERS REMARKS:

description of formations encountered	from	to
Top Soil	0	4
red sand	4	8
gray clay	8	12
Blue clay	12	21
sand	21	45


CODED

UGT - 6 1972

MISS. BD. OF
WATER COM.

If well telescopes please sketch and show depths.

GROUND LEVEL

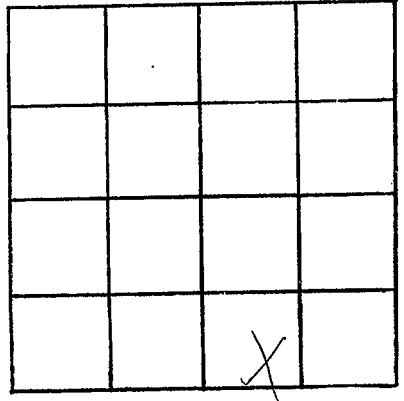

SECTION 30

Please indicate well location X.

ADDITIONAL INFORMATION

If more than one screen,
show locations of each on sketch.