

PERRY
~~FORREST~~
A58
7-28-72

L. F. M.

MISSISSIPPI
BOARD OF WATER COMMISSIONERS
416 North State Street
Jackson, Mississippi 39201

WATER WELL DRILLERS LOG

7-28
date well completed

1972 *Sumner Well Drilling Co*
firm name

PERRY
~~FORREST~~
county well located

LANDOWNER: *David Brady*
R.F.D. 8
Hattiesburg miss.
(mailing address)

description of formations encountered	from	to
	<i>clay</i>	<i>0</i>
<i>hard clay</i>	<i>21</i>	<i>48</i>
<i>clay</i>	<i>48</i>	<i>64</i>
<i>fine sand</i>	<i>64</i>	<i>76</i>
<i>hard sand</i>	<i>76</i>	<i>83</i>
<i>Gravelly sand</i>	<i>83</i>	<i>118</i>

WELL LOCATION:
sec. *2* T. *4* N. R. *16* E.
5 S. *5* S. *16* W.
11 miles *FE* *Dural*
(distance) (direction) (nearest town)

WELL PURPOSE: *Home*
(home, irrigation, municipal, industrial)


WELL COMPLETION DATA:
(1) diameter (inches) *2"*
(2) total depth (feet) *118 ft*
(3) static water level (feet) *78 ft* below top of ground.
(4) casing *Plastic, 113 ft*
(material) (depth)
2" If telescope see back.
(size)
(5) screen *5 ft, 118 ft*
(length) (depth to top)
2" *Plastic*
(size) (material)
(6) pump *1* *800 gpm*
(HP) (yield gpm)
jet
(type power)
(7) electric log (yes or no)
(organization running log)
(8) how well bottom plugged *close*

DRILLERS REMARKS:

SEP 12 1972

If well telescopes please sketch and show depths.

GROUND LEVEL

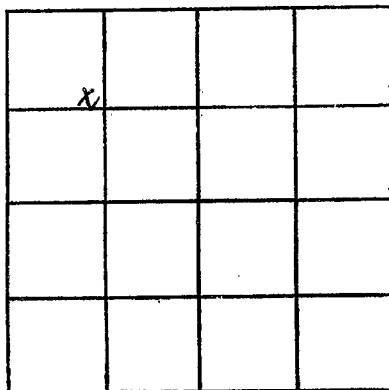

SECTION _____

Please indicate well location X.

ADDITIONAL INFORMATION

If more than one screen, show locations of each on sketch.