

MISSISSIPPI
 BOARD OF WATER COMMISSIONERS
 416 North State Street
 Jackson, Mississippi 39201

WATER WELL DRILLERS LOG

CODED

PERRY
 A 59
 11-28-72

November 28 1972 Cookson Drilling Inc. Perry
 date well completed firm name county well located

LANDOWNER: Ray R. Williams
Rt 9, Hazleberg
 (mailing address)

description of formations encountered	from	to
Top Soil	0	3
Red Sand	3	9
Red Clay	9	13
Gray Clay	13	28
Sand	28	45

WELL LOCATION:
 sec. 32 T. 5 N. R. 11 E.
 S. W.
3 miles West of Emmitt
 (distance) (direction) (nearest town)

WELL PURPOSE: home
 (home, irrigation, municipal, industrial)

- WELL COMPLETION DATA:
- (1) diameter (inches) 2
 - (2) total depth (feet) 45
 - (3) static water level (feet) 11 ^{below} _{above} top of ground.
 - (4) casing PVC 40'
 (material) (depth)
 (size) If telescope see back.
 - (5) screen 5' 40
 (length) (depth to top)
2" PVC
 (size) (material)
 - (6) pump 1 5
 (HP) (yield gpm)
Elect.
 (type power)
 - (7) electric log no
 (yes or no)
 (organization running log)
 - (8) how well bottom plugged value


CODED

FEB 8 1973

DRILLERS REMARKS:

If well telescopes please sketch and show depths.

GROUND LEVEL

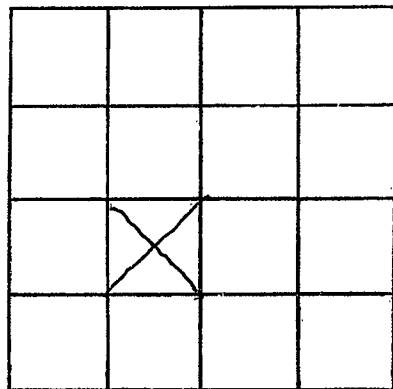

SECTION 32

Please indicate well location X.

ADDITIONAL INFORMATION

If more than one screen,
show locations of each on sketch.