

PERRY
A 61
7-14-73

MISSISSIPPI
 BOARD OF WATER COMMISSIONERS
 416 North State Street
 Jackson, Mississippi 39201

CODED

WATER WELL DRILLERS LOG

July 14 1973 Cochran Drillers Perry
 date well completed firm name county well located

LANDOWNER:
 Margie Watkins
 Rt. 8, Natchitoches
 (mailing address)

description of formations encountered	from	to
top soil	0	4
brown clay	4	10
gray clay	10	14
red gravel	14	45

WELL LOCATION:
 sec. 32 T 5 N R 11 E
 S W
 8 miles East of Petal
 (distance) (direction) (nearest town)

WELL PURPOSE: none
 (home, irrigation, municipal, industrial)

WELL COMPLETION DATA:

(1) diameter (inches) 2 1/2

(2) total depth (feet) 45

(3) static water level (feet) 8 (below top of ground) above

(4) casing PUC 40'
 (material) (depth)

_____ If telescope see back.
 (size)

(5) screen 5' 40'
 (length) (depth to top)

2" PUC
 (size) (material)

(6) pump 1 9
 (HP) (yield gpm)

Ebat.
 (type power)

(7) electric log No
 (yes or no)

_____ (organization running log)

(8) how well bottom plugged valve


CODED

DRILLERS REMARKS:

NOV 5 1973

If well telescopes please sketch and show depths.

GROUND LEVEL

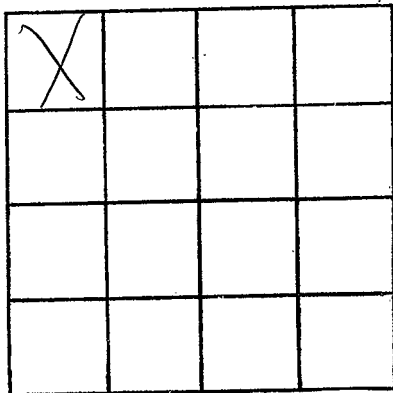

SECTION 32

Please indicate well location X.

ADDITIONAL INFORMATION

If more than one screen,
show locations of each on sketch.