

Perry
A62
10-8-73

MISSISSIPPI
BOARD OF WATER COMMISSIONERS
416 North State Street
Jackson, Mississippi 39201

WATER WELL DRILLERS LOG **CODED**

Oct. 8 1973 Cochran Drillers Perry
date well completed firm name county well located

LANDOWNER:
Thomas Hinton
Rt. 3, Nattiesburg
(mailing address)

| description of formations encountered | from | to |
|---------------------------------------|------|----|
| Top soil | 0 | 3 |
| red clay | 3 | 6 |
| brown clay | 6 | 12 |
| gray clay | 12 | 26 |
| blue clay | 26 | 31 |
| sand | 31 | 45 |

WELL LOCATION:
sec 20 T 5 N R 11 E
S W
10 miles East of Petal
(distance) (direction) (nearest town)

WELL PURPOSE: home
(home, irrigation, municipal, industrial)

WELL COMPLETION DATA:

(1) diameter (inches) 2"

(2) total depth (feet) 45'

(3) static water level (feet) 18 below top of ground.

(4) casing PVC 40'
(material) (depth)

_____ if telescope see back.
(size)

(5) screen 5' 40'
(length) (depth to top)

2" PVC
(size) (material)

(6) pump 1 6
(HP) (yield gpm)

Elect
(type power)

(7) electric log no
(yes or no)

_____ (organization running log)

(8) how well bottom plugged Valve


CODED

DRILLERS REMARKS:

NOV 5 1973

If well telescopes please sketch and show depths.

GROUND LEVEL

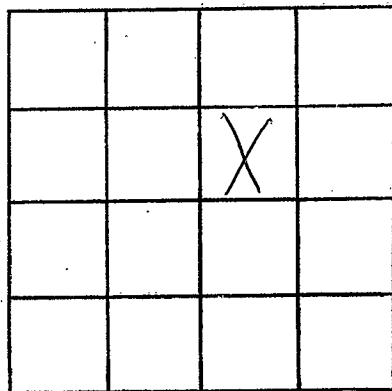

SECTION 20

Please indicate well location X.

ADDITIONAL INFORMATION

If more than one screen,
show locations of each on sketch.