

C. P. CLARK

MISSISSIPPI WATER WELL DRILLING
BOARD OF WATER COMMISSIONERS STE 2
416 North State Street, JREL, MISS. 39440
Jackson, Mississippi 39201

CODED

WATER WELL DRILLERS LOG

Perry
A63
9-26-74
118

C.P. Clark

Perry

9/26, 1974
date well completed

C.P. Clark
firm name

Perry
county well located

LANDOWNER: Runnelstown
Utility District
Runnelstown Miss
(mailing address)


WELL LOCATION:
sec 21 T 5 N R 11 E
1 miles North of Runnelstown
(distance) (direction) (nearest town)

description of formations encountered	from	to
2/5/74 Red Clay	0	6
White Clay	6	12
Sandy Clay	12	18
White Clay	18	84
Sand streaks	84	88
Clay	88	125
Hard Sand streaks	125	160
Clay	160	175
Fine Sand	175	179
Hard Clay	179	240
Soft Clay Sand streaks	240	260
Hard Clay	260	272
Fine Sand	272	281
Clay	281	286
Clay Sand streaks	286	297
Fine Sand	297	320
Medium Sand	320	330
Coarse Sand	330	380
Hard Clay	380	386

WELL PURPOSE: Community System
(home, irrigation, municipal, industrial)

- WELL COMPLETION DATA:
- (1) diameter (inches) 8
 - (2) total depth (feet) 330
 - (3) static water level (feet) 16 below above top of ground.
 - (4) casing 328 Black Iron
(material) (depth)
6in if telescope see back.
(size)
 - (5) screen 40, 338
(length) (depth to top)
6in Solid S.S.
(size)
 - (6) pump 15 50PSI
(HP) (yield gpm)
230V 3φ 275 @ 12PSI
(type power)
 - (7) electric log Yes in Test Hole
(yes or no)
U.S. G.S.
(organization running log)
 - (8) how well bottom plugged B.W.V

CODED

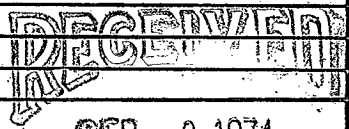

DRILLERS REMARKS: 10ft
Drawdown @ 2007 P.M.

If well telescopes please sketch and show depths.

GROUND LEVEL

X			

SECTION _____

Please indicate well location X.

ADDITIONAL INFORMATION

If more than one screen, show locations of each on sketch.