

PERRY
A 64
2-18-74

MISSISSIPPI
BOARD OF WATER COMMISSIONERS
416 North State Street
Jackson, Mississippi 39201

WATER WELL DRILLERS LOG **CODED**

2-18-1974 date well completed
Hammell Drilling Co Perry firm name
county well located

LANDOWNER Jerry Dyer
R.F.D. 8 - Box 472
Hattiesburg Miss
(mailing address)


description of formations encountered	from	to
clay	0	11
fine sand	11	20
coast sand	20	26

WELL LOCATION:
sec. 2 T 5 N R 11 E
S W
14 miles SW of Hattiesburg
(distance) (direction) (nearest town)

WELL PURPOSE: HOME
(home, irrigation, municipal, industrial)

- WELL COMPLETION DATA:
- (1) diameter (inches) 2"
 - (2) total depth (feet) 26 ft
 - (3) static water level (feet) 16 below top of ground.
 - (4) casing plastic 21 ft
(material) (depth)
2" If telescope see back.
(size)
 - (5) screen 5 ft 26 ft
(length) (depth to top)
2" plastic
(size) (material)
 - (6) pump 3/4 600 gpm
(HP) (yield gpm)
her
(type power)
 - (7) electric log (yes or no)
(organization running log)
 - (8) how well bottom plugged close

CODED

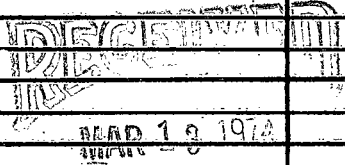

DRILLERS REMARKS:

If well telescopes please sketch and show depths.

GROUND LEVEL

X			

SECTION

Please indicate well location X.

ADDITIONAL INFORMATION

If more than one screen, show locations of each on sketch.