

Perry
A 2000
11/76

MISSISSIPPI
BOARD OF WATER COMMISSIONERS
416 North State Street
Jackson, Mississippi 39201

WATER WELL DRILLERS LOG

11-1976
date well completed

J.R. Grover Water Well Drilling
firm name


PERRY
county well located

LANDOWNER:	description of formations encountered	from	to
L.M. Shoemaker	SAND	0	10
R#DNE	"	10	15
Ovett, Ms (mailing address)	White Clay	15	20
	" "	20	30
WELL LOCATION:	Blue "	30	40
sec. 10 T. 50 N. R. 11 E.	" "	40	50
2 5/8 S. 1/2 Sec. 15 miles S of Ellisville	" "	50	54
(distance) (direction) (nearest town)	SAND	54	56
WELL PURPOSE:	" Chalk	56	60
(home, irrigation, municipal, industrial)	" "	60	70
WELL COMPLETION DATA:	" "	70	80
(1) diameter (inches) 4	" "	80	90
(2) total depth (feet) 150	" "	90	100
(3) static water level (feet) 62 below top of ground.	" "	100	110
(4) casing PVC 135 (material) (depth)	fine SAND	110	120
(size) If telescope see back.	" "	120	135
(5) screen 15' 135 (length) (depth to top)	" "	130	140
" 2x008 PVC (size) (material)	" "	140	150
(6) pump 1 15 (HP) (yield gpm)	HARD	150	-
110 VAC (type power)			
(7) electric log NO (yes or no)			
(organization running log)			
(8) how well bottom plugged			
DRILLERS REMARKS:			

RECEIVED
JAN 11 1977

If well telescopes please
sketch and show depths.

GROUND LEVEL

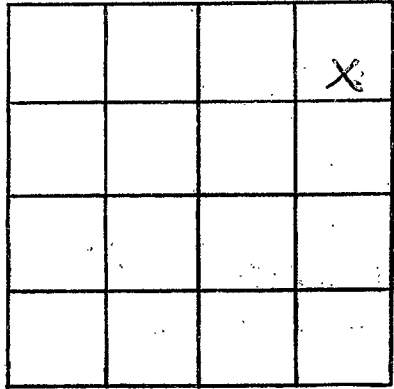

SECTION 10

Please indicate well location X.

ADDITIONAL INFORMATION

If more than one screen,
show locations of each on sketch.