

Perry  
 AP 2001  
 7-18-81

MISSISSIPPI  
 BOARD OF WATER COMMISSIONERS  
 416 North State Street  
 Jackson, Mississippi 39201

WATER WELL DRILLERS LOG

June 18 1981 Cochran Brothers Drilling PERRY  
 date well completed firm name county well located

LANDOWNER:  
 Homer Pearce  
 Rt 12 Hattiesburg  
 (mailing address)

WELL LOCATION:  
 sec. 1 T. 5 N. R. 11 E. S. 5  
 7 miles NE of Ridgeland  
 (distance) (direction) (nearest town)

WELL PURPOSE:  
 (home, irrigation, municipal, industrial)

- WELL COMPLETION DATA:
- (1) diameter (inches) 2"
  - (2) total depth (feet) 175'
  - (3) static water level (feet) 60 below above top of ground.
  - (4) casing PVC 165'  
 (material) (depth)  
 2" if telescope see back.  
 (size)
  - (5) screen 10' 165'  
 (length) (depth to top)  
 2" PVC  
 (size) (material)
  - (6) pump 1 6  
 (HP) (yield gpm)  
 Elec  
 (type power)
  - (7) electric log no  
 (yes or no)  
 (organization running log)
  - (8) how well bottom plugged valve


description of formations encountered	from	to
TOP Soil	0	1
Red clay	1	9
Sand + GRAVEL	9	23
GRAY CLAY	23	48
Blue clay	48	71
Fine clay	71	79
Blue clay	79	138
sand	138	142
Blue clay	142	149
sand	149	175

DRILLERS REMARKS:

DEPT. OF NATURAL RESOURCES  
 BUREAU OF LAND & WATER RESOURCES  
 JUL 22 1981  
 RECEIVED

If well telescopes please sketch and show depths.

GROUND LEVEL

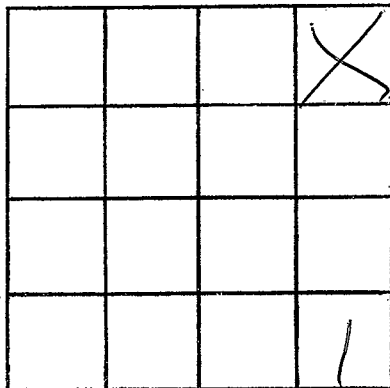

SECTION \_\_\_\_\_

Please indicate well location X.

ADDITIONAL INFORMATION

If more than one screen,  
show locations of each on sketch.