

Perry  
A  
2002

MISSISSIPPI  
BOARD OF WATER COMMISSIONERS  
416 North State Street  
Jackson, Mississippi 39201

WATER WELL DRILLERS LOG

Aug 12 1983 C.P. Clark Waterwell Perry  
date well completed firm name county well located

LANDOWNER: Thompson, Simpson  
(M-G Nursery, Inc)  
Rte 1, Box 94A, Duck, Mo.  
(mailing address)

WELL LOCATION:  
sec. 3 T. 5 N R. 11 E  
3 1/2 miles N of Summit Station  
(distance) (direction) (nearest town)

WELL PURPOSE: Irrigation  
(home, irrigation, municipal, industrial)

- WELL COMPLETION DATA:
- (1) diameter (inches) 4
  - (2) total depth (feet) 359'
  - (3) static water level (feet) 68' below top of ground.
  - (4) casing Galv. St. 339'  
(material) (depth)
  - (5) screen 15', 339'  
(length) (depth to top)  
4", Stainless Steel  
(size) (material)
  - (6) pump 5 64 @ 40#  
(HP) (yield gpm)  
230 V 1Ø 78 @ 0#  
(type power)
  - (7) electric log no  
(yes or no)
  - (8) how well bottom plugged BWV

description of formations encountered	from	to
Top soil	0	1
Red clay w/ some pebbles	1	6
White & gray clay	6	69
Sandy streaks of clay	69	76
Tan clay	76	83
Sand w/ clay breaks	83	88
Green clay	88	102
Sand & clay streaks	102	113
clay	113	121
Sandy clay w/ pebbles	121	127
clay	127	135
Hard fine green sand	135	149
clay	149	149 1/2
Very fine sand	149 1/2	152
clay	152	255
Sand & clay mixed	255	267
Sand	267	271
Sandy clay	271	274
Sand	274	280
clay w/ red streaks	280	291
Sand, fine powder	291	354
in top, mid to cre. in bottom. 20 ft.		
Lignite & carb. clay	354	355
Sand	355	358
clay	358	359

DEPT. OF NATURAL RESOURCES  
BUREAU OF LAND & WATER RESOURCES


AUG 29 1983

RECEIVED

DRILLERS REMARKS:

If well telescopes please sketch and show depths.

GROUND LEVEL

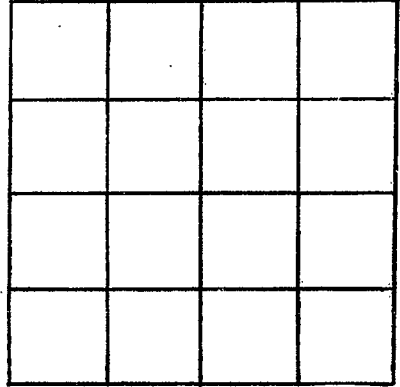

SECTION \_\_\_\_\_

Please indicate well location X.

ADDITIONAL INFORMATION

If more than one screen, show locations of each on sketch.