

# MISSISSIPPI DEPARTMENT OF NATURAL RESOURCES

Bureau of Land and Water Resources

P.O. Box 10631

Jackson, Mississippi 39209

## WATER WELL DRILLERS LOG

COUNTY WELL LOCATED <b>Perry</b>	
WELL NUMBER <b>A2003</b>	CODED
DATE WELL COMPLETED <b>April 5-87</b>	

PERMIT NUMBER
NAME OF DRILLING FIRM <b>Cochran Water Well Service</b>

NAME & MAILING ADDRESS OF LANDOWNER <b>Bobby Temple</b>			
<b>RT 10 Hattiesburg</b>			
WELL LOCATION:	SEC	TOWNSHIP	RANGE
	<b>6</b>	<b>5</b>	<b>11</b>
		<b>N</b> S	<b>E</b> W
DISTANCE	DIRECTION	NEAREST TOWN	
<b>6</b> Miles	<b>NW</b>	<b>Rumpleston</b>	
OTHER LANDMARK			
WELL PURPOSE: <input checked="" type="radio"/> Home <input type="radio"/> Irrigation, Municipal, Industrial, Fish Pond, etc.			

PUMP DATA		
PUMP TYPE (Circle One): Submersible, Turbine, Jet, Flowing Well, Other (Describe) _____		
POWER TYPE (Circle One): Electric, Tractor, Diesel, Gasoline, Butane, Other (Describe) _____		
Pump Capacity (GPM)	No. of Stages	Setting Depth
		FT.
PUMP TEST		
Well yielded _____ GPM with a drawdown of _____ ft. after _____ hours of pumping		

WELL DATA		
Well Depth <b>38'</b>	Casing Diameter (In.) <b>2</b>	Casing Length (Ft.) <b>33</b>
Type of Casing <b>PVC</b>	Hole Depth <b>40'</b>	Depth to Static Water Level <b>26'</b>
TYPE OF COMPLETION: (Circle One or More): <input checked="" type="checkbox"/> Gravel Packed, <input type="checkbox"/> Underreamed, <input type="checkbox"/> Telescoped, <input type="checkbox"/> Natural Development, <input type="checkbox"/> Open Hole, <input type="checkbox"/> Other (Describe) _____		
Top of Lap Pipe or Reduction in Casing		
FEET	IF TELESCOPED OR MORE THAN ONE SCREEN: USE BACK PAGE	

LOG DATA	
TYPE OF LOG RUN (Circle One): Electric, Gamma Ray, Density, Sonic, Neutron, Other (Describe) _____	
<input checked="" type="radio"/> No Log Run	
Name of Organization Running Log	

SCREEN DATA		
Diameter - Inches <b>2</b>	Length - Feet <b>5</b>	Slot Size - Inches <b>10</b>
Screen Type <b>PVC</b>	Depth to Bottom - Feet <b>38</b>	


GEOLOGIC DATA (Office Use Only)			
Surface Elev.	Geologic Unit	Unit Thickness	Depth to Top
Subs. SWL	Date	Analysis	Aquifer Test
Driller's Remarks			

DESCRIPTION OF FORMATIONS ENCOUNTERED	FROM	TO
<b>Top Soil</b>	<b>0</b>	<b>2</b>
<b>Red clay</b>	<b>2</b>	<b>4</b>
<b>Gray clay</b>	<b>4</b>	<b>9</b>
<b>sand</b>	<b>9</b>	<b>38</b>

<div style="font-size: 2em; font-weight: bold; opacity: 0.5;">RECEIVED</div> <p style="font-size: 1.5em; font-weight: bold;">JUN 08 1987</p> <p style="font-weight: bold;">Department of Natural Resources Bureau of Land &amp; Water Resources</p>	<table border="1" style="width: 100%; border-collapse: collapse;"> <thead> <tr> <th>FORMATION (Continued)</th> <th>FROM</th> <th>TO</th> </tr> </thead> <tbody> <tr><td> </td><td> </td><td> </td></tr> <tr><td> </td><td> </td><td> </td></tr> <tr><td> </td><td> </td><td> </td></tr> <tr><td> </td><td> </td><td> </td></tr> <tr><td> </td><td> </td><td> </td></tr> <tr><td> </td><td> </td><td> </td></tr> <tr><td> </td><td> </td><td> </td></tr> <tr><td> </td><td> </td><td> </td></tr> <tr><td> </td><td> </td><td> </td></tr> <tr><td> </td><td> </td><td> </td></tr> </tbody> </table>	FORMATION (Continued)	FROM	TO																														
FORMATION (Continued)	FROM	TO																																
IF MORE SPACE IS NEEDED, USE BACK																																		

If well telescopes please sketch and show depths.

GROUND LEVEL

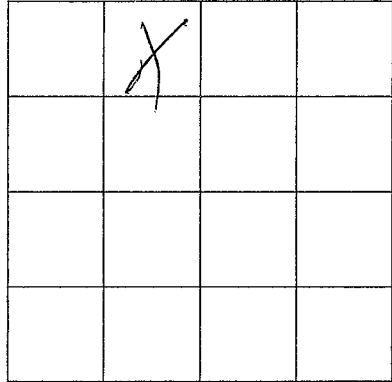

SECTION 6

Please indicate well location X.

ADDITIONAL INFORMATION

If more than one screen, show location of each on sketch.