

MISSISSIPPI DEPARTMENT OF NATURAL RESOURCES

Bureau of Land and Water Resources

P.O. Box 10631

Jackson, Mississippi 39209

WATER WELL DRILLERS LOG

COUNTY WELL LOCATED Perry	
WELL NUMBER A 2004	CODED
DATE WELL COMPLETED MAY 18-87	

PERMIT NUMBER
NAME OF DRILLING FIRM Cochran Water Well Service

NAME & MAILING ADDRESS OF LANDOWNER Steve Walters			
Rt 10 Nattiesburg			
WELL LOCATION: SEC	TOWNSHIP	RANGE	
6	5	11	W
DISTANCE	DIRECTION	NEAREST TOWN	
5 Miles	N-W	of Runklestown	
OTHER LANDMARK			
WELL PURPOSE: <input checked="" type="radio"/> Home Irrigation, <input type="radio"/> Municipal, <input type="radio"/> Industrial, <input type="radio"/> Fish Pond, etc.			

PUMP DATA			
PUMP TYPE (Circle One): <input checked="" type="radio"/> Submersible, <input type="radio"/> Turbine, <input type="radio"/> Jet <input type="radio"/> Flowing Well, Other (Describe) _____			
POWER TYPE (Circle One): <input checked="" type="radio"/> Electric, <input type="radio"/> Tractor, <input type="radio"/> Diesel, <input type="radio"/> Gasoline, <input type="radio"/> Butane, Other (Describe) _____			
Pump Capacity (GPM)	No. of Stages	Setting Depth	
15	11	70'	FT.
PUMP TEST			
Well yielded 15 GPM with a drawdown of 15 ft. after 8 hours of pumping			

WELL DATA		
Well Depth 78'	Casing Diameter (In.) 4	Casing Length (Ft.) 68
Type of Casing PVC	Hole Depth 80'	Depth to Static Water Level 51'
TYPE OF COMPLETION: (Circle One or More): <input checked="" type="radio"/> Gravel Packed, <input type="radio"/> Underreamed, <input type="radio"/> Telescoped, <input checked="" type="radio"/> Natural Development, <input type="radio"/> Open Hole, <input type="radio"/> Other (Describe) _____		
Top of Lap Pipe or Reduction in Casing		
FEET <input type="checkbox"/> IF TELESCOPED OR MORE THAN ONE SCREEN: USE BACK PAGE		

LOG DATA	
TYPE OF LOG RUN (Circle One): <input checked="" type="radio"/> No Log Run, <input type="radio"/> Electric, <input type="radio"/> Gamma Ray, <input type="radio"/> Density, <input type="radio"/> Sonic, <input type="radio"/> Neutron, Other (Describe) _____	
Name of Organization Running Log	

SCREEN DATA		
Diameter - Inches 4	Length - Feet 10	Slot Size - Inches 10
Screen Type PVC	Depth to Bottom - Feet 78	


GEOLOGIC DATA (Office Use Only)			
Surface Elev.	Geologic Unit	Unit Thickness	Depth to Top
Subs. SWL	Date	Analysis	Aquifer Test
Driller's Remarks			

DESCRIPTION OF FORMATIONS ENCOUNTERED	FROM	TO
TOP Soil	0	1
Red CLAY	1	6
Gray clay	6	78
sand	18	78

FORMATIONS (Continued)	FROM	TO
RECEIVED		
JUN 08 1987		
Department of Natural Resources Bureau of Land & Water Resources		
IF MORE SPACE IS NEEDED, USE BACK		

If well telescopes please sketch and show depths.

GROUND LEVEL

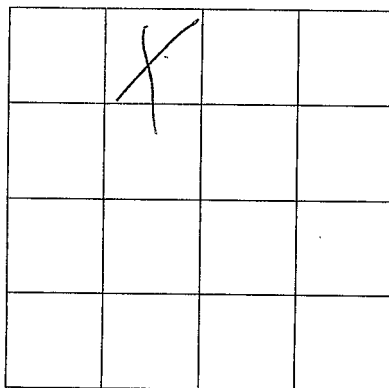

SECTION 6

Please indicate well location X.

ADDITIONAL INFORMATION

If more than one screen,
show location of each on sketch.