

MISSISSIPPI DEPARTMENT OF NATURAL RESOURCES

Bureau of Land and Water Resources

P.O. Box 10631

Jackson, Mississippi 39209

WATER WELL DRILLERS LOG

COUNTY WELL LOCATED Perry	
WELL NUMBER A	CODED
DATE WELL COMPLETED 2007 Nov. 14-1998	

PERMIT NUMBER
NAME OF DRILLING FIRM Cochran Water Well Service

NAME & MAILING ADDRESS OF LANDOWNER Mrs. Ricketson Old Richton Rd Petala			
WELL LOCATION:	SEC	TOWNSHIP	RANGE
	19	5	N 11 E
DISTANCE	DIRECTION	NEAREST TOWN	
3 Miles	N-W	of Rumley	
OTHER LANDMARK			
WELL PURPOSE: Home, Irrigation, Municipal, Industrial, Fish Pond, etc.			

PUMP DATA		
PUMP TYPE (Circle One): Submersible, Turbine, Jet Flowing Well, Other (Describe) _____		
POWER TYPE (Circle One): Electric Tractor, Diesel, Gasoline, Butane, Other (Describe) _____ H/P _____		
Pump Capacity (GPM) 8	No. of Stages 2	Setting Depth 40 FT.
PUMP TEST		
Well yielded 8 GPM with a drawdown of _____ ft. after _____ hours of pumping		

WELL DATA		
Well Depth 300'	Casing Diameter (In.) 2	Casing Length (Ft.) 290
Type of Casing PVC	Hole Depth 300'	Depth to Static Water Level 21'
TYPE OF COMPLETION: (Circle One or More): Gravel Packed, Underreamed, Telescoped, Natural Development , Open Hole, Other (Describe) _____		
Top of Lap Pipe or Reduction in Casing		
FEET	IF TELESCOPED OR MORE THAN ONE SCREEN: USE BACK PAGE	

LOG DATA	
TYPE OF LOG RUN (Circle One): No Log Run, Electric, Gamma Ray, Density, Sonic, Neutron, Other (Describe) _____	
Name of Organization Running Log	

SCREEN DATA		
Diameter - Inches 2	Length - Feet 10	Slot Size - Inches 12
Screen Type PVC	Depth to Bottom - Feet 300	


GEOLOGIC DATA (Office Use Only)			
Surface Elev.	Geologic Unit	Unit Thickness	Depth to Top
Subs. SWL	Date	Analysis	Aquifer Test
Driller's Remarks			

DESCRIPTION OF FORMATIONS ENCOUNTERED	FROM	TO	FORMATIONS (Continued)	FROM	TO
TOP Soil	0	1	DISCOVERED RESERVED DEC 10 1990 Department of Natural Resources Bureau of Land & Water Resources		
RED CLAY	1	7			
RED Sand	7	11			
Gray CLAY	11	14			
Blue CLAY	14	17			
Sand	17	24			
Blue CLAY	24	241			
Sand	241	300			

IF MORE SPACE IS NEEDED, USE BACK

If well telescopes please sketch and show depths.

GROUND LEVEL

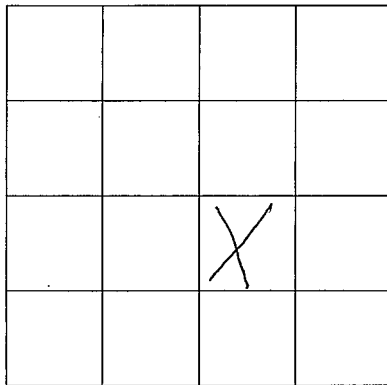

SECTION 19

Please indicate well location X.

ADDITIONAL INFORMATION

If more than one screen,
show location of each on sketch.