

MISSISSIPPI DEPARTMENT OF NATURAL RESOURCES

Bureau of Land and Water Resources

Southport Mall

P.O. Box 10631

Jackson, Mississippi 39209

WATER WELL DRILLERS LOG

Perry
A
2008

March 3-1984
 date well completed

Cochran Water Well Service
 firm name

Perry
 county well located

LANDOWNER:	description of formations encountered	from	to
<u>Steve Walters</u>			
<u>Rt. 10 Nattiesburg</u> (mailing address)	<u>TOP Soil</u>	<u>0</u>	<u>1</u>
	<u>Red clay</u>	<u>1</u>	<u>10</u>
	<u>Red Sand</u>	<u>10</u>	<u>21</u>
	<u>Gray clay</u>	<u>21</u>	<u>62</u>
	<u>sand</u>	<u>62</u>	<u>80</u>
WELL LOCATION:			
sec. <u>6</u> T <u>3</u> N R. <u>11</u> E			
<u>4</u> miles <u>N</u> of <u>Runklesboro</u>			
(distance) (direction) (nearest town)			
WELL PURPOSE:			
<u>(home) irrigation, municipal, industrial</u>			
WELL COMPLETION DATA:			
(1) diameter (inches) <u>2"</u>			
(2) total depth (feet) <u>80'</u>			
(3) static water level (feet) <u>35</u> <u>below</u> above top of ground.			
(4) casing <u>PVC</u> , <u>75'</u> (material) (depth)			
<u>2"</u> (size) if telescope see back.			
(5) screen <u>5'</u> , <u>75'</u> (length) (depth to top)			
<u>2"</u> , <u>PVC</u> (size) (material)			
(6) pump _____ (HP) (yield gpm)			
(type power)			
(7) electric log _____ (yes or no)			
(organization running log)			
(8) how well bottom plugged <u>value</u>			
DRILLERS REMARKS:			


DEPT. OF NATURAL RESOURCES
 BUREAU OF LAND & WATER RESOURCES

JUN - 1 1984

RECEIVED

If well telescopes please sketch and show depths.

GROUND LEVEL

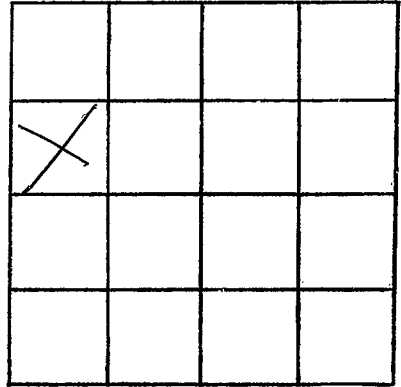

SECTION 6

Please indicate well location X.

ADDITIONAL INFORMATION

If more than one screen,
show locations of each on sketch.