

Perry
 B7
 9-66

MISSISSIPPI BOARD OF WATER COMMISSIONERS

WATER WELL DRILLERS LOG

Date: Sept, 1966, Driller: Peoples Drilling Co County Perry
 (Name)


(1) Owner of Land: Winston Henderson
 (Name)
Rt 2 Richton, Miss.
 (Address)
 (2) Location: NE 1/4, SW 1/4, Sec. 2 T10R10W
9 miles N of Richton
 (distance) (direction) (Nearest Town)
 (3) Topography: Hilly
 (Hilly) (Flat) (Level)
 (4) Purpose of Well: Home
 (Domestic Irrigation
 Municipal, Industrial, Other)

Description & Color of Materials Sand, Clay, Red Clay, Shell, etc.	Thick- ness Feet	Depth Feet
<u>Yellow Sandy Clay</u>	<u>21</u>	<u>21</u>
<u>Yellow sandy clay & small sand streaks</u>	<u>27</u>	<u>48</u>
<u>White clay & small sand streaks</u>	<u>55</u>	<u>97</u>
<u>Blue sandy clay</u>	<u>25</u>	<u>122</u>
<u>yellow sand</u>	<u>19</u>	<u>141</u>

Information upon completion of well:

(1) Diameter 2 inches.
 (2) Total Depth 141 feet.
 (3) Water Level 53 feet below top of ground.
 (4) Cased to 135', Size 2"
 (5) Screen: Size 2", Length 6'
 (6) Were any formations sealed against pollution?
 _____ yes, no.

If YES depth of formation _____
 Why _____
 Drillers Remarks: _____

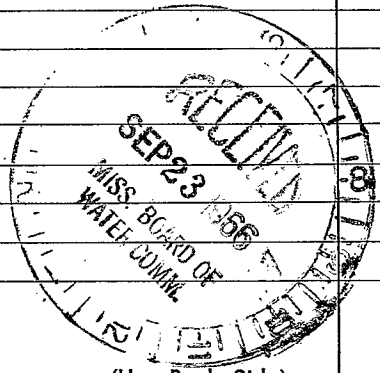

(Use Back Side)

Well No.

