

Perry
B 8
9-67

MISSISSIPPI
 BOARD OF WATER COMMISSIONERS
 416 North State Street
 Jackson, Mississippi 39201

WATER WELL DRILLERS LOG

Sept 19 67 Peeples Drilling Co Perry
 date well completed firm name county well located

LANDOWNER: H. H. Williford

Richton, Miss.

(mailing address)

WELL LOCATION:

sec. 12 T. 5 N. R. 10 E
S S
4 1/2 miles n. of Richton
 (distance) (direction) (nearest town)

WELL PURPOSE: Home
 (home, irrigation, municipal, industrial)

WELL COMPLETION DATA:


- (1) diameter (inches) 2
- (2) total depth (feet) 153
- (3) static water level (feet) 52 below above top of ground.
- (4) casing Galv. 147
 (material) (depth)
2' if telescope see back.
 (size)
- (5) screen 6' 147'
 (length) (depth to top)
2' Brass
 (size) (material)
- (6) pump 1 10
 (HP) (yield gpm)
electric
 (type power)
- (7) electric log no
 (yes or no)
 (organization running log)
- (8) how well bottom plugged back
Wash valve

description of formations encountered

from to


<u>red sandy clay</u>	<u>0</u>	<u>18</u>
<u>yellow sand & clay streaks.</u>	<u>18</u>	<u>52</u>
<u>yellow sand</u>	<u>52</u>	<u>75</u>
<u>white sand & chalk streaks</u>	<u>75</u>	<u>130</u>
<u>white sand</u>	<u>130</u>	<u>153</u>

DRILLERS REMARKS:

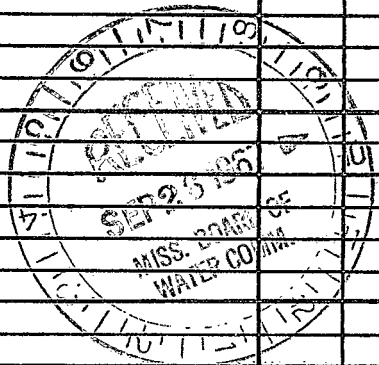

If well telescopes please sketch and show depths.

GROUND LEVEL

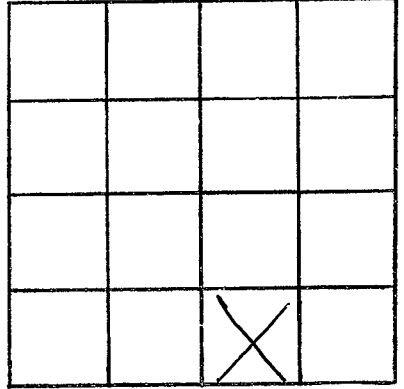

SECTION 12

Please indicate well location X.

ADDITIONAL INFORMATION

If more than one screen,
show locations of each on sketch.