

Perry
B9
1-68

MISSISSIPPI
BOARD OF WATER COMMISSIONERS
416 North State Street
Jackson, Mississippi 39201

WATER WELL DRILLERS LOG

Jan 1968 Peoples Drilling Co Perry
Date well completed firm name county well located

LANDOWNER: J. D. McLean
Rt 2, Richton, Miss
(mailing address)


description of formations encountered	from	to
yellow sandy clay	0	21
yellow sandy clay & sand streak	21	103
yellow sand	103	124

WELL LOCATION:
sec. 12 T. 56 N. R. 10 E. S. 5 W.
5 miles N of Richton
(distance) (direction) (nearest town)

WELL PURPOSE: Home
(home, irrigation, municipal, industrial)

- WELL COMPLETION DATA:
- (1) diameter (inches) 2
 - (2) total depth (feet) 124
 - (3) static water level (feet) 73 ^{below} _{above} top of ground.
 - (4) casing Galv. 120
(material) (depth)
2 if telescope see back.
(size)
 - (5) screen 6' 120'
(length) (depth to top)
2" Brass
(size) (material)
 - (6) pump 1 10
(HP) (yield gpm)
elect
(type power)
 - (7) electric log no
(yes or no)


(organization running log)
 - (8) how well bottom plugged Back
Work Valve

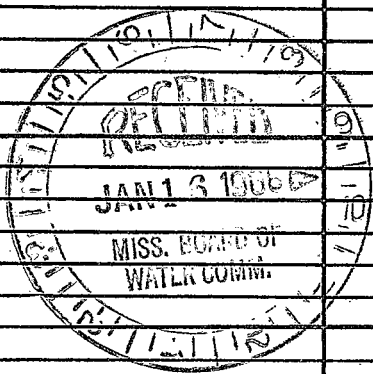

DRILLERS REMARKS:

If well telescopes please sketch and show depths.

GROUND LEVEL

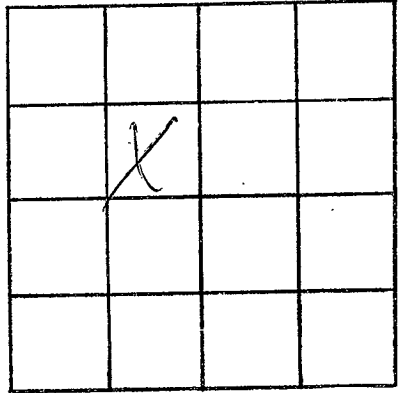

SECTION 12

Please indicate well location X.

ADDITIONAL INFORMATION

If more than one screen,
show locations of each on sketch.