

Perry
B 10

WATER WELL DRILLERS LOG

Date: June 1, 1966 Driller: Timms County: Perry
(Name)

(1) Owner of Land: D. H. M. Queen
(Name)

(Address)

(2) Location: $\frac{1}{4}$, $\frac{1}{4}$, Sec. 36 ^{N. W.} _{WEST} ^{T. 5} _{WEST} ^{R. 16} _{WEST},
1/4 miles East, of Rehoboth
(distance) (direction) (Nearest Town)

(3) Topography: (Hilly) (Flat) (Level)

(4) Purpose of Well: Domestic
(Domestic Irrigation
Municipal, Industrial, Other)

Description & Color of Materials Sand, Clay, Red Clay, Shell, etc.	Thick- ness Feet	Depth Feet
<u>0-15</u> <u>red sand</u>	<u>0</u>	<u>15</u>
<u>15-35</u> <u>red sand</u>	<u>15</u>	<u>35</u>
<u>35-40</u> <u>white clay</u>	<u>35</u>	<u>40</u>
<u>40-66</u> <u>gravel</u>	<u>40</u>	<u>66</u>


Information upon completion of well:

- (1) Diameter 2 inches.
- (2) Total Depth 66 feet.
- (3) Water Level 40 feet below top of ground.
- (4) Cased to 61, Size 2 in.
- (5) Screen: Size 2", Length 5 ft.
- (6) Were any formations sealed against pollution?
_____ yes, no.

If YES depth of formation _____

Why _____

Drillers Remarks: _____

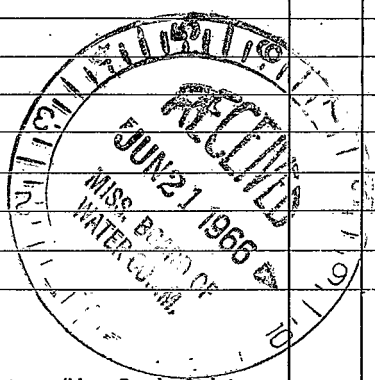

(Use Back Side)

Well No.

