

PERRY

MISSISSIPPI BOARD OF WATER COMMISSIONERS

B14

# WATER WELL DRILLERS LOG

# CODED

10-65

Date: Oct, 1965, Driller: Reple's Drilling Co County Perry  
298/21 (Name)

- (1) Owner of Land: H. J. Iney  
(Name)  
Rt 3 Richton  
(Address)
- (2) Location: 1/4, 1/4, Sec. 33 T. 5. R. 10,  
Buck Creek Community  
miles, of  
(distance) (direction) (Nearest Town)
- (3) Topography: Hilly  
(Hilly) (Flat) (Level)
- (4) Purpose of Well: Home  
(Domestic Irrigation, Municipal, Industrial, Other)

Description & Color of Materials Sand, Clay, Red Clay, Shell, etc.	Thick- ness Feet	Depth Feet
<u>Yellow sandy clay</u>	<u>19</u>	<u>19</u>
<u>White clay</u>	<u>23</u>	<u>42</u>
<u>yellow sandy clay</u>	<u>60</u>	<u>102</u>
<u>Blue sandy clay</u>	<u>16</u>	<u>118</u>
<u>yellow sand &amp; gravel</u>	<u>12</u>	<u>130</u>

## Information upon completion of well:


- (1) Diameter 2 inches.
- (2) Total Depth 80 feet.
- (3) Water Level 55 feet below top of ground.
- (4) Cased to 74', Size 2"
- (5) Screen: Size 2", Length 6'
- (6) Were any formations sealed against pollution?  
\_\_\_\_\_yes, \_\_\_\_\_no.

# CODED

If YES depth of formation \_\_\_\_\_

Why \_\_\_\_\_

Drillers Remarks: \_\_\_\_\_

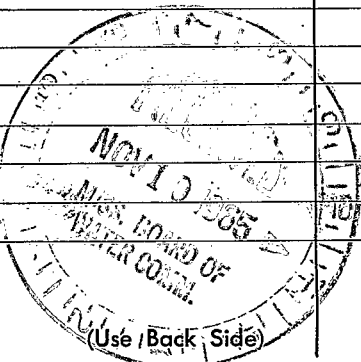

Well No.

100