

PERRY
B 18
3-68

MISSISSIPPI
BOARD OF WATER COMMISSIONERS
416 North State Street
Jackson, Mississippi 39201

WATER WELL DRILLERS LOG

March 19 68 Peoples Drilling Co Perry
date well completed firm name county well located

LANDOWNER: Henry Thompson

description of formations encountered from to

R 22

Red sand & clay shale 0 42

Richton, Miss (mailing address)

Yellow sand & sandy clay 42 63

WELL LOCATION:
sec 12 T 5(N) R 12(E)
4 miles W of Richton (distance) (direction) (nearest town)

Blue sandy shale & sand streak 63 160

WELL PURPOSE: Home (home, irrigation, municipal, industrial)

Fine white sand 160 181

WELL COMPLETION DATA:

Blue shale & fine sand streak 181 336

(1) diameter (inches) 2

Fine sand 336 420

(2) total depth (feet) 489

Sand 420 489

(3) static water level (feet) 96 (below top of ground)

(4) casing Galv. 483 (material) (depth) 2' (size) if telescope see back.

(5) screen 6' 483 (length) (depth to top) 2" (size) Brass (material)

(6) pump 1 5 (HP) (yield gpm) electric (type power)

(7) electric log NO (yes or no)

(organization running log)


(8) how well bottom plugged Back Wash Valve



DRILLERS REMARKS:

If well telescopes please sketch and show depths.

GROUND LEVEL

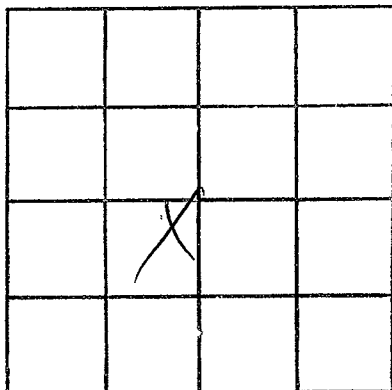

SECTION 12

Please indicate well location X.

ADDITIONAL INFORMATION

If more than one screen,
show locations of each on sketch.