

PERRY
B 19
3-68

MISSISSIPPI
BOARD OF WATER COMMISSIONERS
416 North State Street
Jackson, Mississippi 39201

WATER WELL DRILLERS LOG

March 19 68 Reep's Drilling Co Perry
date well completed firm name county well located

LANDOWNER: H. H. Harris
Rt 2
Richton, Miss.
(mailing address)
WELL LOCATION:
sec. 2 T. 50 N R. 10 E
0 miles N of Richton
(distance) (direction) (nearest town)

description of formations encountered	from	to
yellow sandy clay + sand streak	0	42
Blue sandy shale	42	126
Blue shale	126	210
Blue sandy shale + sand streak	210	336
gray shaly sand	336	357
gray sand	357	447


WELL PURPOSE: Home
(home, irrigation, municipal, industrial)

WELL COMPLETION DATA:

- (1) diameter (inches) 2
- (2) total depth (feet) 447
- (3) static water level (feet) 92 ^{below} _{above} top of ground.
- (4) casing Galv. 441
(material) (depth)
2" if telescope see back.
(size)
- (5) screen 6' 441
(length) (depth to top)
2" Brass
(size) (material)
- (6) pump 1 5
(HP) (yield gpm)
electric
(type power)
- (7) electric log No
(yes or no)
- (organization running log)


(8) how well bottom plugged back
Wash valve

DRILLERS REMARKS:

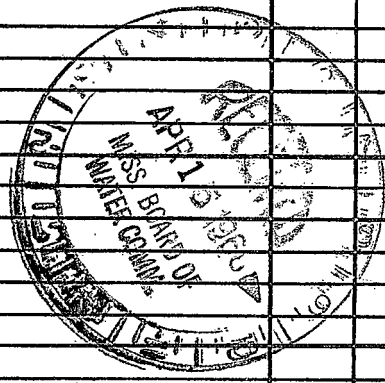

If well telescopes please sketch and show depths.

GROUND LEVEL

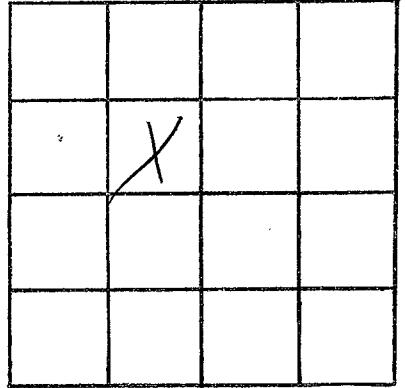

SECTION 2

Please indicate well location X.

ADDITIONAL INFORMATION

If more than one screen,
show locations of each on sketch.