

PERRY  
B 20  
3-68

MISSISSIPPI  
BOARD OF WATER COMMISSIONERS  
416 North State Street  
Jackson, Mississippi 39201

WATER WELL DRILLERS LOG

3/27 1968 STR Perry  
date well completed firm name county well located


LANDOWNER: A.P. Rabinow  
Richton, Miss.  
(mailing address)

WELL LOCATION:  
sec. 25 T 5 N R 10 E  
S W  
1 miles NW of Richton  
(distance) (direction) (nearest town)

WELL PURPOSE: Home  
(home, irrigation, municipal, industrial)

- WELL COMPLETION DATA:
- (1) diameter (inches) 2"
  - (2) total depth (feet) 64 ft
  - (3) static water level (feet) 31 below above top of ground
  - (4) casing Plastic, 59 ft (material) (depth)
  - 2" If telescope see back. (size)
  - (5) screen 5 ft, 59 ft (length) (depth to top)
  - 2" Plastic (size) (material)
  - (6) pump 1 900 Hr (HP) (total gpm)
  - 1/2 (type power)
  - (7) electric log no (yes or no)
  - none (organization running log)
  - (8) how well bottom plugged Valve

description of formations encountered	from	to
Blue Clay	0	31
Fine Sand	31	54
Coar. S. Sand	54	64
White Clay	64	72
unknown		

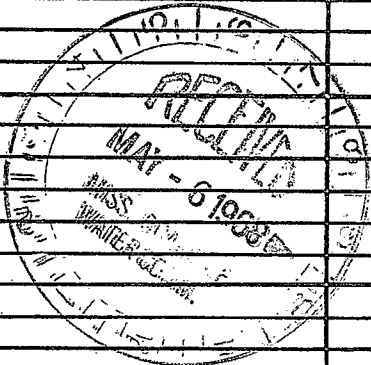

DRILLERS REMARKS:

If well telescopes please sketch and show depths.

GROUND LEVEL

	X		

SECTION 25

Please indicate well location X.

ADDITIONAL INFORMATION

If more than one screen, show locations of each on sketch.