

PERRY
B 23
USGS
6/16/69

MISSISSIPPI
BOARD OF WATER COMMISSIONERS
416 North State Street
Jackson, Mississippi 39201

CODED

WATER WELL DRILLERS LOG

6-16 1969 STP Perry
date well completed firm name county well located

LANDOWNER: Joe Blackmon

Richter Miss
(mailing address)

WELL LOCATION:
sec. 25 T 15 N R 10 E
S W
1 miles W of Richter
(distance) (direction) (nearest town)

WELL PURPOSE:
(home, irrigation, municipal, industrial)

- WELL COMPLETION DATA:
- (1) diameter (inches) 4"
 - (2) total depth (feet) 412 ft
 - (3) static water level (feet) 76 below top of ground.
 - (4) casing (material) 397 (depth)
 - 4" (size) if telescope see back.
 - (5) screen 15 (length) 397 (depth to top)
 - 4" (size) 8/5 (material)
 - (6) pump 5 (HP) 54 (yield gpm)
 - Subc. (type power) #89
 - (7) electric log Yes (yes or no)
USGS (organization running log)
 - (8) how well bottom plugged Valve


description of formations encountered	from	to
Sandy clay	0	10
white clay	10	17
Fine Sand	17	28
Blue Shale	28	43
W + Brown Clay	43	58
Blue Clay	58	121
Strips W + B + Grey Clay	121	134
blue clay	134	143
Fine Sand	143	148
Heavy Clay	148	163
Sand Strips	163	175
Blue Clay	175	193
Grey + Brown Shale	193	320
Rock	320	321
Blue Shale	321	393
White W.B. Sand	393	412
White Clay	412	423
Blue Shale Sand	423	541
Sand	541	560
Rock	560	562
Sand	562	583
Rock	583	584

DRILLERS REMARKS:

JUN 14 1969
MISSISSIPPI
STATE BOARD OF WATER COMMISSIONERS

If well telescopes please sketch and show depths.

GROUND LEVEL

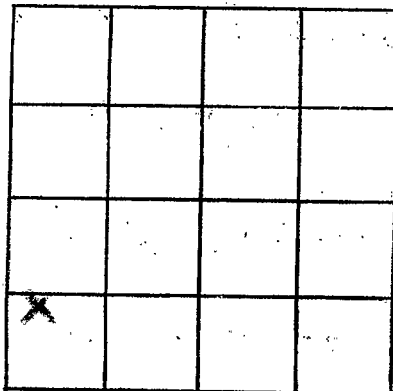

SECTION 25th

Please indicate well location X.

ADDITIONAL INFORMATION

If more than one screen,
show locations of each on sketch.