

PERRY
B 24
10-10-69

MISSISSIPPI
BOARD OF WATER COMMISSIONERS
416 North State Street
Jackson, Mississippi 39201

CODED

WATER WELL DRILLERS LOG

10/10 1969 date well completed SFR firm name Perry county well located

LANDOWNER: Richard Forthum
Richard, Miss.
(mailing address)

description of formations encountered	from	to
Clay white	0	8
Sand white fine	8	17
White Clay	17	58
Blue Clay	58	92
Fine S.D.	92	94
Blue Clay	94	130
Blue Sand	130	140

WELL LOCATION:
sec. 32 T. 5 N. R. 10 E.
5 miles W of Richard
(distance) (direction) (nearest town)

WELL PURPOSE: Home
(home, irrigation, municipal, industrial)


- WELL COMPLETION DATA:
- (1) diameter (inches) 2"
 - (2) total depth (feet) 140
 - (3) static water level (feet) 21 below above top of ground.
 - (4) casing plastic 130
(material) (depth)
2" If telescope see back.
(size)
 - (5) screen 10 130
(length) (depth to top)
2" plastic
(size) (material)
 - (6) pump 1/2 1000
(HP) (yield gpm)
1/2
(type power)
 - (7) electric log _____
(yes or no)
(organization running log)
 - (8) how well bottom plugged blue

DRILLERS REMARKS:

NOV 21 1969
MISS. Bd. of
Water Comm.

If well telescopes please sketch and show depths.

GROUND LEVEL

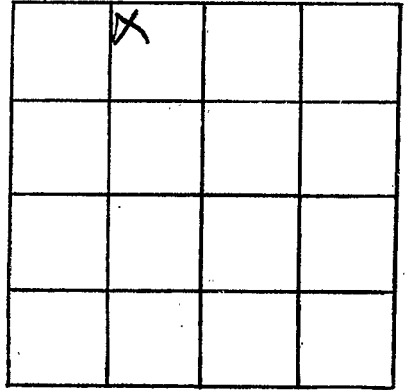

SECTION 32

Please indicate well location X.

ADDITIONAL INFORMATION

If more than one screen,
show locations of each on sketch.