

PERRY
B 25
2-7-70

MISSISSIPPI
BOARD OF WATER COMMISSIONERS
416 North State Street
Jackson, Mississippi 39201

CODED

WATER WELL DRILLERS LOG

2-7 1970 SFR Perry
dr's well completed firm name county well located

LANDOWNER: W W Anderson

Pt 2
Pickton, Miss
(mailing address)

WELL LOCATION:

sec 15 T 5 N R 10 E
S W
3 miles NW of Pickton
(distance) (direction) (nearest town)

WELL PURPOSE: Home
(home, irrigation, municipal, industrial)

WELL COMPLETION DATA:

- (1) diameter (inches) 4"
- (2) total depth (feet) 145
- (3) static water level (feet) 77 below above top of ground.
- (4) casing plastic, 120,
(material) (depth)
1/2" if telescope see back.
(size)
- (5) screen 25 ft, 120
(length) (depth to top)
1/2", plastic
(size) (material)
- (6) pump 1/2 900 GPM
(HP) (yield gpm)
Sub
(type power)
- (7) electric log _____
(yes or no)

(organization running log)
- (8) how well bottom plugged None

description of formations encountered	from	to
Red Clay	0	14
Light Shale	14	24
Brown Clay	24	28
Grey Clay	28	36
White Sand	36	113
Fine Sand	113	123
CW B Sand	123	147

FEB 19 1970


MISS. BD. OF
WATER COMM.

DRILLERS REMARKS:

Sound packed

If well telescopes please sketch and show depths.

GROUND LEVEL

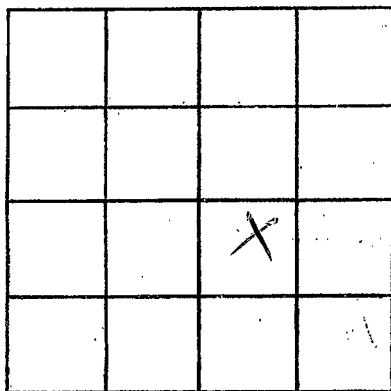

SECTION 15

Please indicate well location X.

ADDITIONAL INFORMATION

If more than one screen, show locations of each on sketch.