

MISSISSIPPI  
BOARD OF WATER COMMISSIONERS  
416 North State Street  
Jackson, Mississippi 39201

**CODED**

WATER WELL DRILLERS LOG

PERRY  
B 28  
8-17-70

Aug. 17 1970 Tim W. Billing Service, Rayney  
date well completed firm name county well located

LANDOWNER: Graham

description of formations encountered

from

to

Route 2  
Richtown, Miss.  
(mailing address)

<u>red clay</u>	<u>0</u>	<u>25</u>
<u>fine sand</u>	<u>25</u>	<u>32</u>
<u>blue clay</u>	<u>32</u>	<u>70</u>
<u>sand</u>	<u>70</u>	<u>85</u>

WELL LOCATION:

sec 33 T 5 N R 10 E  
3 1/2 miles S.W. of Richtown  
(distance) (direction) (nearest town)

WELL PURPOSE: home  
(home, irrigation, municipal, industrial)

WELL COMPLETION DATA:

- (1) diameter (inches) 2 in.
- (2) total depth (feet) 85 ft.
- (3) static water level (feet) 76 below above of ground.
- (4) casing plastic 80  
(material) (depth)  
1/2 (size) if telescope see back.
- (5) screen 5 ft. 80  
(length) (depth to top)  
2 in. plastic  
(size) (material)
- (6) pump 1 5  
(HP) (yield gpm)  
elec.  
(type power)
- (7) electric log no  
(yes or no)

**CODED**

(organization running log)

AUG 28 1970


(8) how well bottom plugged B.P.  
valve

MISS. BD. OF  
WATER COMM.

DRILLERS REMARKS:

If well telescopes please sketch and show depths.

GROUND LEVEL

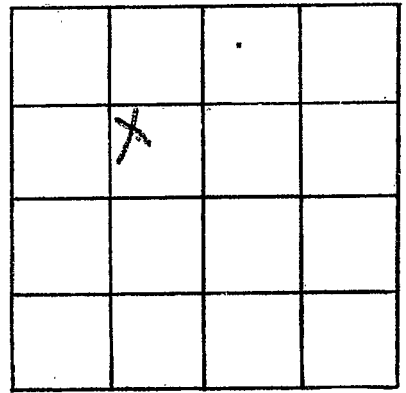

SECTION: 33

Please indicate well location X.

ADDITIONAL INFORMATION

Lined area for additional information.

If more than one screen, show locations of each on sketch.