

PERRY
B 29
11-10-70

MISSISSIPPI
BOARD OF WATER COMMISSIONERS
416 North State Street
Jackson, Mississippi 39201

CODED

WATER WELL DRILLERS LOG

Nov 10 19 70 Cochran Drilling Service Perry
date well completed firm name county well located

LANDOWNER:
Shell Oil Co.
(mailing address)

description of formations encountered	from	to
Sand	0	2
Clay Red	2	8
Sand	8	16
Sand & Gravel	16	25

WELL LOCATION:
sec. 15 T. 5 S. R. 10 E
7 miles N.W. of Ridgeway
(distance) (direction) (nearest town)

WELL PURPOSE: Home
(home, irrigation, municipal, industrial)

WELL COMPLETION DATA:

(1) diameter (inches) 2

(2) total depth (feet) 25

(3) static water level (feet) 9 below top of ground.

(4) casing PVC, 20 (material) (depth)
(size) if telescope see back.

(5) screen 5, 20 (length) (depth to top)
2, PVC (size) (material)

(6) pump 1/4, 4 (HP) (yield gpm)
Elec (type power)

(7) electric log No (yes or no)
(organization running log)

(8) how well bottom plugged Valve

CODED


JAN 22 1971

DRILLERS REMARKS:

MISS. BD. OF
WATER COMM.

If well telescopes please sketch and show depths.

GROUND LEVEL

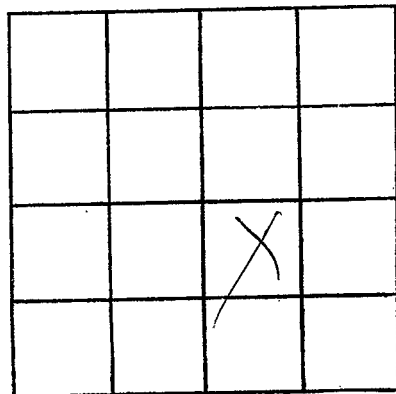

SECTION 15

Please indicate well location X.

ADDITIONAL INFORMATION

If more than one screen, show locations of each on sketch.