

MISSISSIPPI
BOARD OF WATER COMMISSIONERS
416 North State Street
Jackson, Mississippi 39201

CODED
Mar 10 1971
Perry

WATER WELL DRILLERS LOG

PERRY
B 30
3-10-71

Mar 10 19 *71* *Clark Key West* *Jones*
date well completed firm name county well located

LANDOWNER: *L.M. Clark*
P.O. Box 101 Rickston
Miss
(mailing address)

WELL LOCATION:
sec *32* T *50* S R *10* E
0 miles *W* of *Rickston*
(distance) (direction) (nearest town)

WELL PURPOSE: *home*
(home, irrigation, municipal, industrial)

- WELL COMPLETION DATA:
- (1) diameter (inches) *2 in*
 - (2) total depth (feet) *610*
 - (3) static water level (feet) *58* below above top of ground.
 - (4) casing *Galv* *600*
(material) (depth)
if telescope see back.
(size)
 - (5) screen *10* *600*
(length) (depth to top)
1 1/4 *St. Steel*
(size) (material)
 - (6) pump *1 1/2* *9*
(HP) (yield gpm)
REA
(type power)
 - (7) electric log *No*
(yes or no)
 - (organization running log)
 - (8) how well bottom plugged *Wash valve*

description of formations encountered	from	to
<i>Clay</i>	<i>0</i>	<i>4</i>
<i>Sand</i>	<i>4</i>	<i>18</i>
<i>Clay</i>	<i>18</i>	<i>38</i>
<i>Sand</i>	<i>38</i>	<i>45</i>
<i>Clay</i>	<i>45</i>	<i>140</i>
<i>Sand</i>	<i>140</i>	<i>143</i>
<i>Clay</i>	<i>143</i>	<i>400</i>
<i>fine sand</i>	<i>400</i>	<i>412</i>
<i>Clay</i>	<i>412</i>	<i>585</i>
<i>Sand</i>	<i>585</i>	<i>610</i>

CODED


MAR 30 1971

MISS. RD. CO.
WATER CONCERN

DRILLERS REMARKS:

If well telescopes please sketch and show depths.

GROUND LEVEL

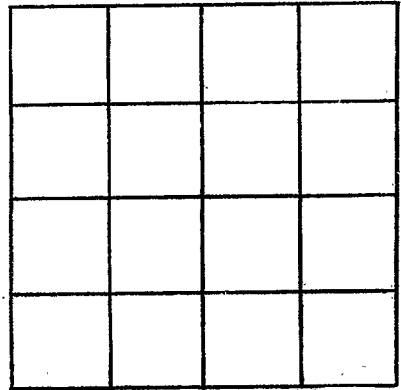

SECTION _____

Please indicate well location X.

ADDITIONAL INFORMATION

If more than one screen, show locations of each on sketch.