

PERRY  
B 31

MISSISSIPPI BOARD OF WATER COMMISSIONERS

12-7-63

WATER WELL DRILLERS LOG

**CODED**

Date: 12-7, 1963, Driller: J. N. Moore County Louisiana  
29717  
(Name)

(1) Owner of Land: <u>CURT EDWARDS</u> <u>Bert Edward</u> (Name)	Description & Color of Materials Sand, Clay, Red Clay, Shell, etc.	Thick- ness Feet	Depth Feet
<u>Richton Mrs's RT 3.</u> (Address)	<u>Surface 0</u>	<u>10</u>	
(2) Location: _____ 1/4, _____ 1/4, Sec. <u>32 T 5 R 10</u> ,	<u>Sand &amp; Gravel 10</u>	<u>56</u>	
_____ miles _____, of <u>Richton</u> (distance) (direction) (Nearest Town)			
(3) Topography: _____ (Hilly) (Flat) (Level)			
(4) Purpose of Well: <u>Home use</u> (Domestic Irrigation Municipal, Industrial, Other)			

Information upon completion of well:


- (1) Diameter 3" inches.
- (2) Total Depth 56 feet.
- (3) Water Level 10 feet below top of ground.
- (4) Cased to 56, Size 3".
- (5) Screen: Size 3", Length 6.
- (6) Were any formations sealed against pollution?  
\_\_\_\_\_ yes, \_\_\_\_\_ no.

If YES depth of formation \_\_\_\_\_

Why \_\_\_\_\_

Drillers Remarks: \_\_\_\_\_

**CODED**

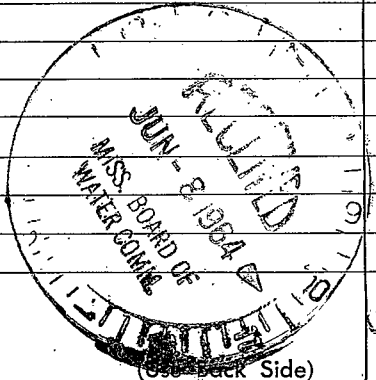

Well No. 33

92  
1  
8  
3900  
13  
13  
13