

PERRY
B33
6-10-71

MISSISSIPPI
BOARD OF WATER COMMISSIONERS
416 North State Street
Jackson, Mississippi 39201

CODED

WATER WELL DRILLERS LOG

June 10 1971 date well completed
Eckman Drilling Co. Perry firm name
county well located

LANDOWNER:
Circle Kinton
Route 3 Richtown
(mailing address)

description of formations encountered	from to	
top soil	0	4
clay sand	4	18
shale	18	24

WELL LOCATION:
sec. 32 T 5 N R 10 E
5 1/2 miles E of Richtown
(distance) (direction) (nearest town)

WELL PURPOSE: Home
(home, irrigation, municipal, industrial)

- WELL COMPLETION DATA:
- (1) diameter (inches) 2
 - (2) total depth (feet) 24
 - (3) static water level (feet) 8 below top of ground.
 - (4) casing PVC 19 (material) (depth)
if telescope see back.
 - (5) screen 5 19 (length) (depth to top)
2 PVC (size) (material)
 - (6) pump 1/2 6 1/2 (HP) (yield gpm)
Eckman (type power)
 - (7) electric log No (yes or no)
(organization running log) Valley
 - (8) how well bottom plugged

CODED


JUN 28 1971

MISS. BD. OF
WATER COMMISSIONERS

DRILLERS REMARKS:

If well telescopes please sketch and show depths.

GROUND LEVEL

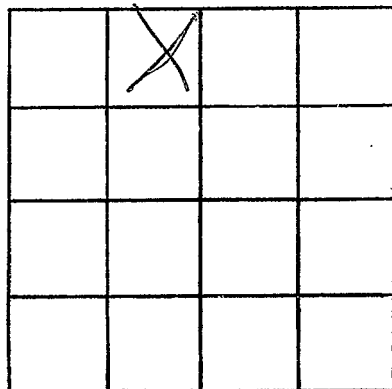

SECTION 32

Please indicate well location X.

ADDITIONAL INFORMATION

If more than one screen,
show locations of each on sketch.