

PERRY
B35
11-17-71

MISSISSIPPI
 BOARD OF WATER COMMISSIONERS
 416 North State Street
 Jackson, Mississippi 39201

CODED 1971

WATER WELL DRILLERS LOG

Nov 17 1971 Roy West Waterwells Perry
 date well completed firm name county well located

LANDOWNER Masonite corp description of formations encountered from to
po Box 1048 Laurel Clay 0 12
Miss Clay 12 147
 (mailing address) sand 147 157

WELL LOCATION:
 sec 28 T 10 R 10 E
2 miles W of Rehnton
 (distance) (direction) (nearest town)

WELL PURPOSE: shop
 (home, irrigation, municipal, industrial)


- WELL COMPLETION DATA:
- (1) diameter (inches) 2 in
 - (2) total depth (feet) 152
 - (3) static water level (feet) 82 below above top of ground.
 - (4) casing galv 147
 (material) (depth)
 - (size) if telescope see back.
 - (5) screen 10ft 147
 (length) (depth to top)
 - (size) (material)
 - (6) pump 1/2 7
 (HP) (yield gpm)
 - Rca
 (type power)
 - (7) electric log no
 (yes or no)
 - (organization running log)
 - (8) how well bottom plugged wash water

CODED

DRILLERS REMARKS:

If well telescopes please sketch and show depths.

GROUND LEVEL

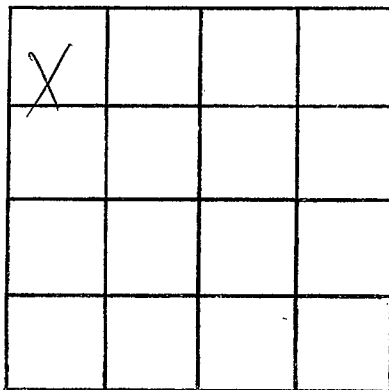

SECTION 28

Please indicate well location X.

ADDITIONAL INFORMATION

If more than one screen,
show locations of each on sketch.