

Perry
B 36
12-24-71

MISSISSIPPI
 BOARD OF WATER COMMISSIONERS
 416 North State Street
 Jackson, Mississippi 39201

FEB - 7 1972

WATER WELL DRILLERS LOG

MISS. BD. OF
 WATER COMMISSIONERS
PERRY
 county well located

12-24 1971 date well completed
 Robertsons firm name

LANDOWNER

M. McCord

description of formations encountered

CODED

to

<i>Gravelly clay</i>	0	18'
<i>Red sand</i>	18	35'
<i>Red clay</i>	35	49'
<i>Sand & gravel</i>	49	60'

(mailing address)

WELL LOCATION:

sec 25 T 5 N R 10 E
 S W
 1 miles NW of Richland
 (distance) (direction) (nearest town)

WELL PURPOSE:

(home, irrigation, municipal, industrial)

WELL COMPLETION DATA:


- (1) diameter (inches) 4"
- (2) total depth (feet) 60
- (3) static water level (feet) 148 below above top of ground.
- (4) casing Plastic (material) 55 (depth)
4" (size) If telescope see back.
- (5) screen 54 (length) 55 (depth to top)
4" (size) Plastic (material)
- (6) pump 1/2 (HP) 300 (yield gpm)
Jet (type power)
- (7) electric log _____ (yes or no)
 _____ (organization running log)
- (8) how well bottom plugged Value

CODED

DRILLERS REMARKS:

If well telescopes please sketch and show depths.

GROUND LEVEL

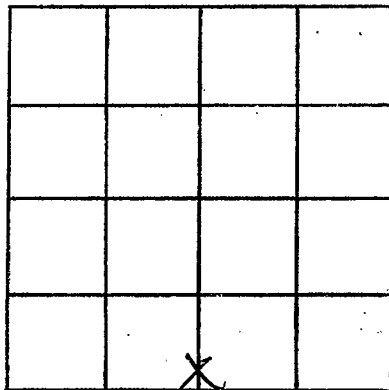

SECTION 25

Please indicate well location X.

ADDITIONAL INFORMATION

Lined area for additional information.

If more than one screen, show locations of each on sketch.